


AREA ANALYSIS			
AREA	m ²	FT ²	%
AE SALES AREA	315.8	3,399	68%
AE FITTING ROOMS	29.4	317	6%
AERIE SALES AREA	0	0	0%
AERIE FITTING ROOMS	0	0	0%
STOCK ROOM	77	829	17%
TOILET ROOM	4.2	45	1%
EGRESS CORRIDOR	0	0	0%
AE DISPLAY	15.1	163	3%
AERIE DISPLAY	0	0	0%
OTHER	0	0	0%
UNUSED	20.9	225	5%
TOTAL	462.5	4978	100%

IMPORTANTE:
RACKS DE BODEGA SON MOSTRADOS CON FINES
ESQUEMATICOS. LA CONFIGURACION ACTUAL
PODRIA VARIAR. REVISAR CANTIDAD, ALTURA Y
POSICION FINAL CON PROVEEDOR REMINGTON.

NOTE:
PRIOR TO INSTALLATION OF STOCKROOM SHELVING &
STOCKROOM ACCESSORY ITEMS, G.C. SHALL VERIFY
THAT ALL STOCKROOM COMPONENTS CAN BE
INSTALLED AS SHOWN ON THIS DRAWING. IF FIELD
CONDITIONS PROHIBIT INSTALLATION AS SHOWN, OR
PRESENT OPPORTUNITIES FOR EXPANSION, G.C.
SHALL NOT CONTINUE WITH ANY INSTALLATION AND
NOTIFY TENANT FIELD REP IMMEDIATELY.

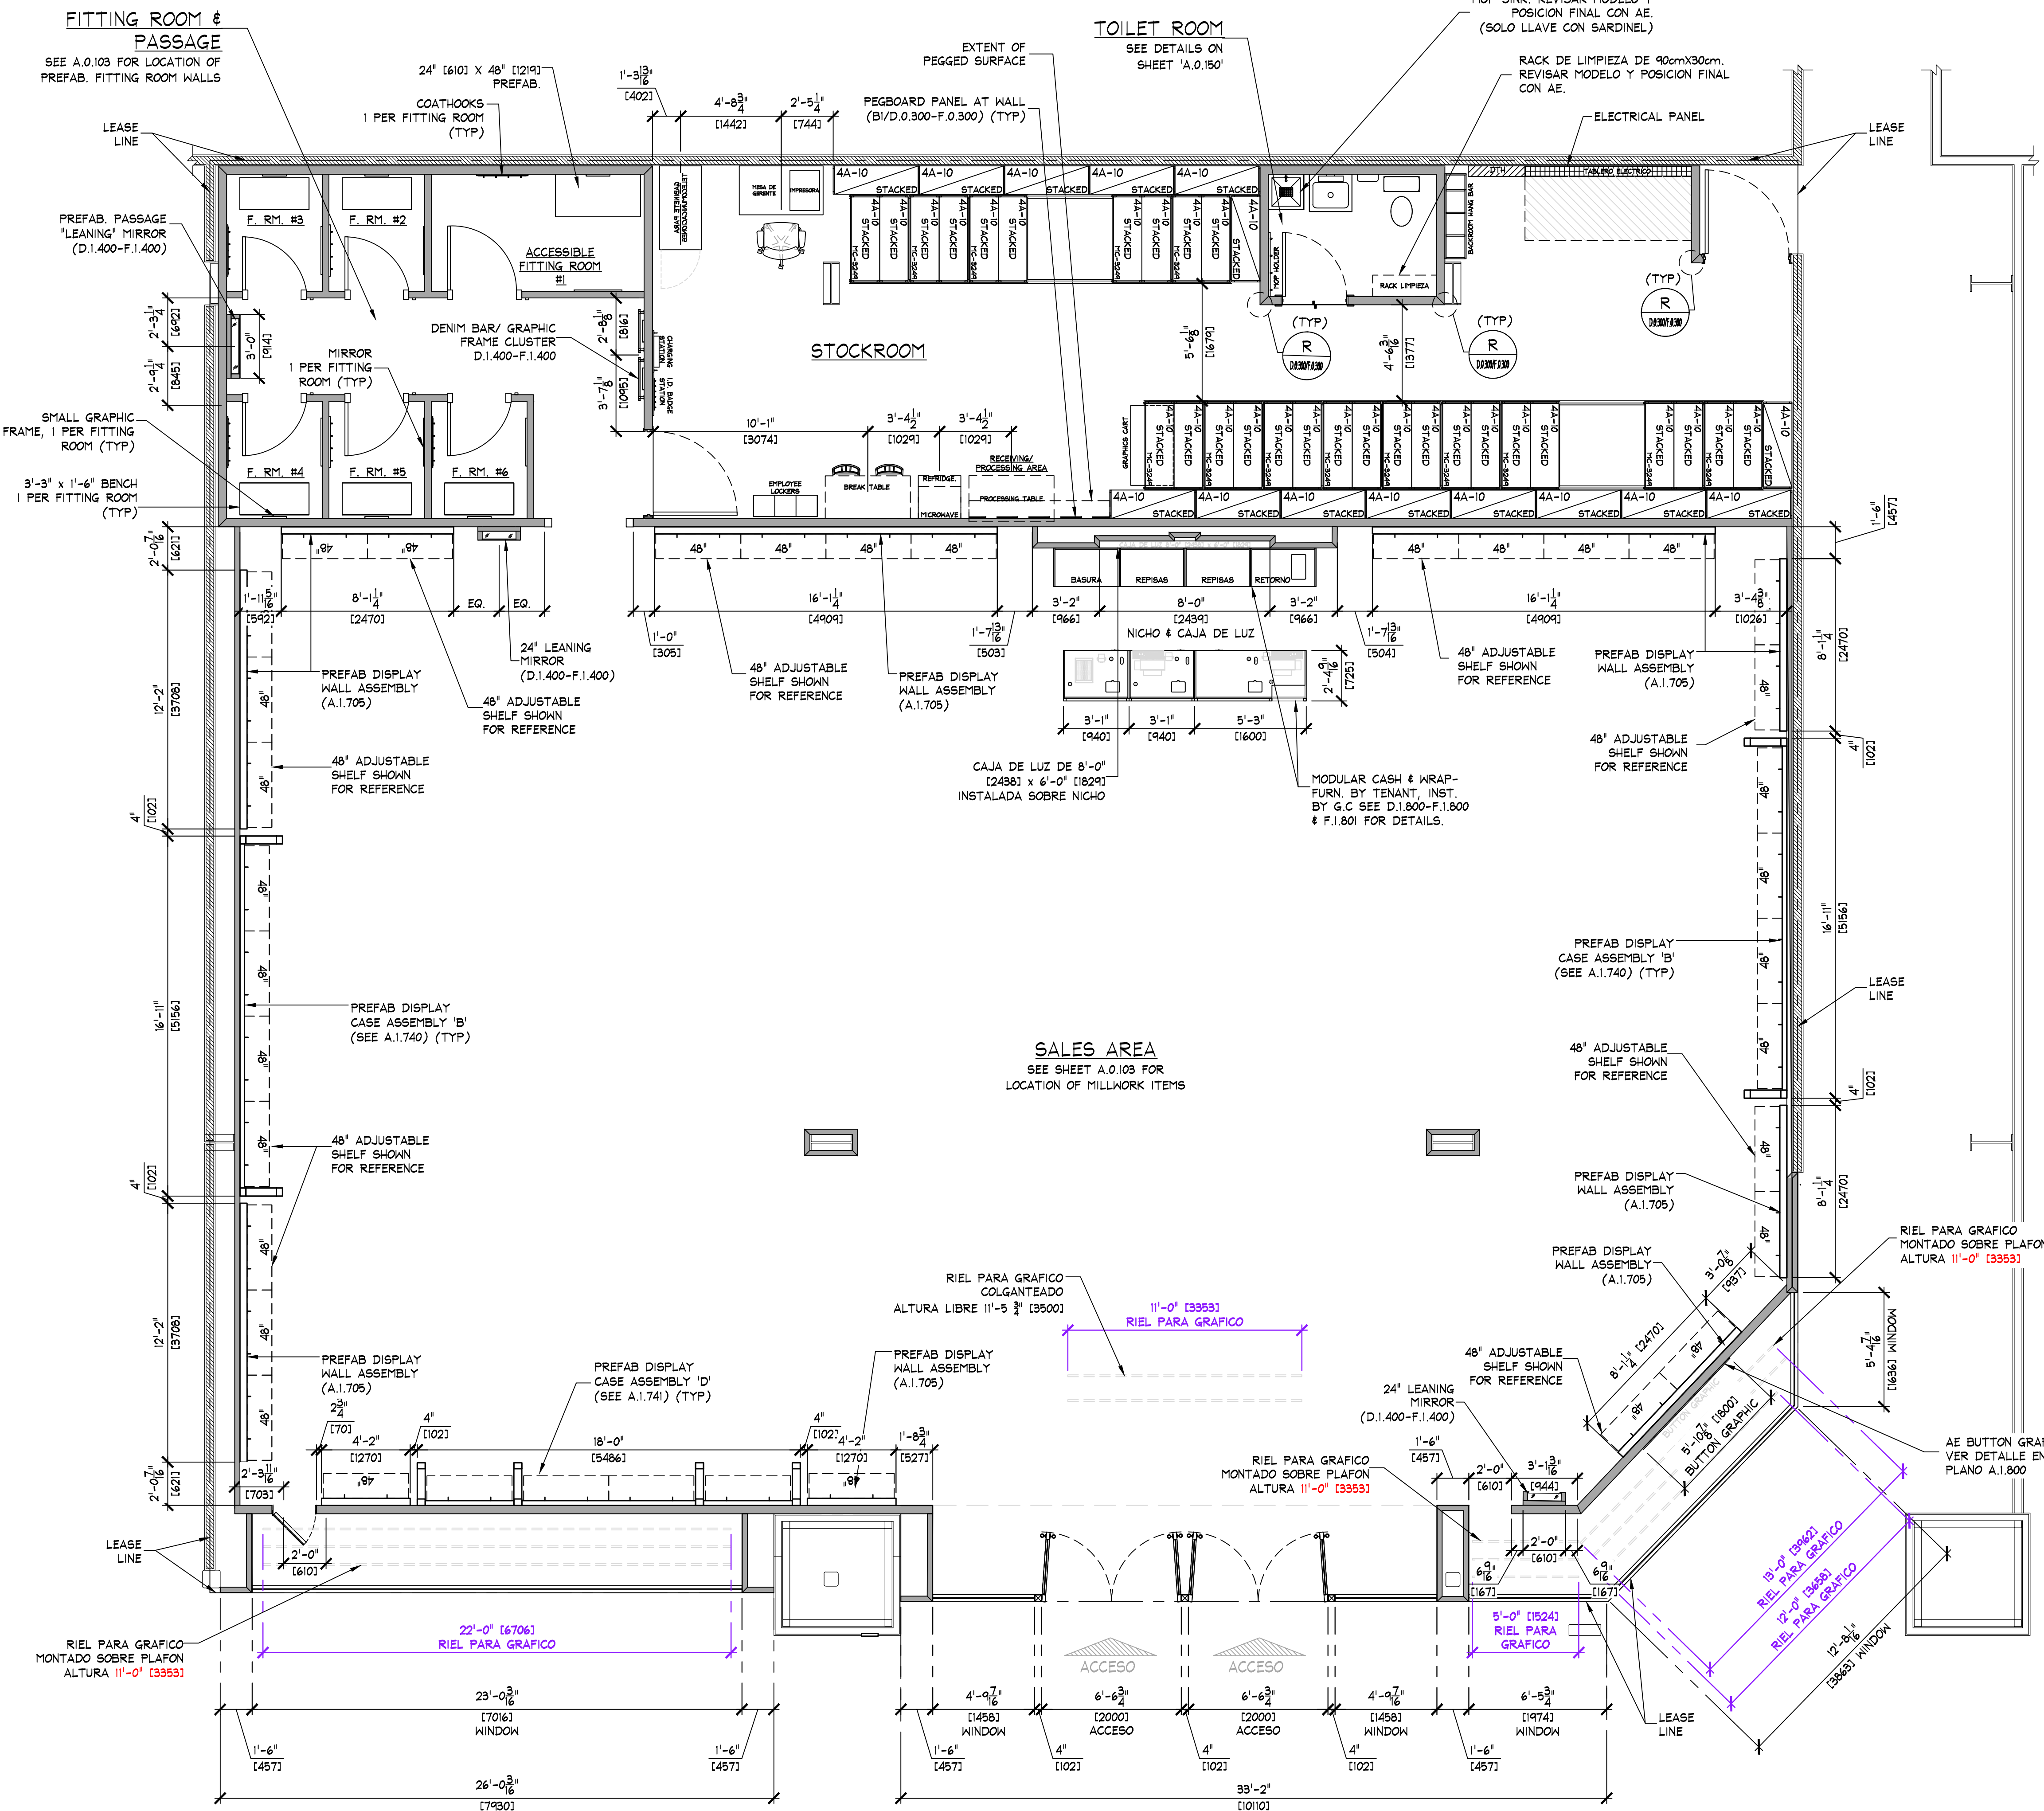

FIXTURE PLAN
SCALE: 1/4" = 1'-0" (1:50)

CONTROL DE CAMBIOS		
BOLETIN	FECHA DE ENTREGA	CAMBIOS GENERALES
1	10 noviembre 2023	Entrega de Proyecto Arquitectonico
2	16 noviembre 2023	Entrega de Proyecto HVAC
3	28 noviembre 2023	Entrega de proyecto de ing. electrica
4	4 noviembre 2023	Se agregan muebles en bodega con informacion AE 27/11/2023 Cambio de mobiliario en area de venta por indicaciones AE 29/11/2023
5	8 diciembre 2023	Ajuste de folios de acceso y aparadores conforme a indicaciones AE
6	13 diciembre 2023	Actualizacion de instalaciones en acceso conforme a indicaciones AE 11/12/2023 Cambio de acabado en cristal de fachada conforme a indicaciones AE 11/12/2023 Actualizacion de proyecto de ingenieria HVAC 12/12/2023 Reubicacion de botonera visual conforme a indicaciones AE 13/12/2023 Cambio de especificacion en letrero de fachada 13/12/2023

NOTAS:
1. PARA VER DETALLE DE CAMBIOS Y PLANOS DONDE SE APLICA, REFERIRSE AL BOLETIN MENCIONADO.
2. LA FECHA INDICADA EN TABLA SE REFIERE A LA ACTUALIZACION EN DRIVE Y ENTREGA DE BOLETIN; PARA REVISAR FECHAS DE REDLINES, REFERIRSE AL ARRIVO CAD.
3. PARA VER DETALLES DE REDLINES Y SU AREA DE EJECUCION DENTRO DEL PROYECTO EN FORMATO PDF, CONSULTAR LA CARPETA 'PDF CON NOTAS INTERNAS'.

SYMBOL LEGEND

- SUPPLY AIR DIFFUSER, WHITE COLOR, **DIFUSOR CIRCULAR PARA ZONAS SIN PLAFON.**
- SUPPLY AIR DIFFUSER (LINEAR), WHITE COLOR, **DIFUSOR LINEAL PARA ZONAS CON PLAFON.**
- SUPPLY AIR DIFFUSER, WHITE COLOR, **DIFUSOR CUADRADO PARA ZONAS CON PLAFON.**
- AREA PARA CORTINA DE AIRE EN ACCESO A TIENDA.
- RETURN / EXHAUST REGISTER (OR GRILLE), WHITE COLOR.
- RECESSED EMERGENCY LIGHT
- SURFACE EMERGENCY LIGHT
- EXIT SIGN
- SHOPPER TRACK
- SECURITY BY OTHERS
ANTENA, VER ALTURA LIBRE A1.300
ANTENA, ALTURA LIBRE (BODIGA) 2.40m

KEY NOTES:

- 2e STOCKROOM CEILING - NO CEILING, UNLESS REQUIRED BY LANDLORD OR LOCAL BUILDING CODES - (ICT-2a). SUSPENSION SYSTEM SHALL BE AS MANUFACTURED BY USG INTERIORS, INC. DOWN CEILING SUSPENSION DXL SERIES, WHITE EXPOSED 2'x4' GRID SYSTEM.
- 3e SIGN - FURNISHED BY SIGN CONSULTANT, INSTALLED BY G.C. SEE SHEET A1.800 FOR MORE INFORMATION.
- 4e REGISTRO EN MURO Y/O PLAFON DE 1'-3" $\frac{1}{4}$ "(400) x 1'-3" $\frac{1}{4}$ "(400) EN ACABADO A IGUALAR INDICADO EN UBICACION REQUERIDA, POR G.C.

ACCESS PANELS SHALL BE AS MANUFACTURED BY HIND-LOCK, STEALTH PANEL WTR-AP024 (TYP). G.C. SHALL FURNISH AND INSTALL ACCESS PANELS FOR ALL NEW AND EXISTING ABOVE CEILING COMPONENTS REQUIRING MAINTENANCE ACCESS (e.g. HVAC UNIT CONTROLS, SHUT OFF VALVES, DAMPER CONTROLS, J-BOXES, ETC. - LANDLORD AND/OR TENANT PROVIDED. G.C. TO VERIFY IN THE FIELD). COORDINATE ALL LOCATIONS WITH TENANT FIELD REPRESENTATIVE.

NOTE:

- ALL SUPPORT TRACK AND RELATED COMPONENTS, REQUIRED TO SUPPORT TRACK LIGHTING FIXTURES ONLY, ARE TO BE FURNISHED BY TENANT & INSTALLED BY G.C. - G.C. SHALL ENSURE THAT ALL SUPPORT TRACK IS INSTALLED WITH FIRST CLASS WORKMANSHIP: LEVEL, STRAIGHT, & ALIGNED.
- ALL OTHER EQUIPMENT/COMPONENT SUPPORTS (UNISTRUT, CLAMPS, NUTS, BOLTS, WASHERS, ETC.) FURN. & INST. BY G.C.

IMPORTANT:

ORANGE COLOR INDICATES STRUCTURAL ELEMENTS.

NOTE:

- ALL COMPONENTS REQUIRED TO SUPPORT AND INSTALL THE SUSPENDED CEILING SYSTEM (WHETHER DRYWALL AND/OR ACOUSTIC TILE), ARE TO BE FURNISHED AND INSTALLED BY G.C. - G.C. SHALL CONSULT WITH MALL/BUILDING DEPARTMENT TO DETERMINE REQUIRED METHODS FOR SUPPORTING CEILING FROM MALL STRUCTURE, PRIOR TO SUBMITTING BID.

NOTE:

- NO WIRING SHALL EXTEND FROM SUPPORT TRACK TO ANY OTHER SUPPORT TRACK, WALL, OR PERIMETER CONSTRUCTION. ALL WIRING RUNS SHALL BE STRAIGHT HORIZONTAL OR VERTICAL. STRAP AND SECURE AS REQUIRED TO MAINTAIN ORGANIZED LOOK.
- ALL WIRING AT PERIMETER WALLS SHALL BE STRAPPED NEATLY HORIZONTAL OR VERTICAL AS REQUIRED.
- ALL VALANCE OR PERIMETER WIRING SHALL BE STRAPPED TIGHTLY TO THE TOP OF VALANCE CABLE TO ELIMINATE VIEW FROM SALES FLOOR.
- ALL ELECTRICAL BOXES SHOULD BE HELD TIGHT TO WALLS.

NOTE:

- ALL EMERGENCY LIGHTING SHALL BE WIRED "HOT" UN-SWITCHED.

NOTE:

- SEE SHEET 'A.0.200' FOR FIXTURE LOCATING DIMENSIONS.

NOTE:

- SECURE ALL LIGHTING TRACK TO CEILING WITH TOGGLE BOLTS WHERE OCCURS.

NOTE:

- SEE SHEET A.0.200 FOR ALL CEILING HEIGHTS.

NOTE:

- SEE SHEET E.0.400 AND/OR E.0.401 FOR ELECTRICAL INSTALLATION DETAILS.

NOTE:

- ALL HVAC INSTALLATION SHALL BE GRAY COLOR TO MATCH (P-5a); ALL DIFFUSERS SHALL BE WHITE COLOR.

NOTE:

- G.C. TO PAINT EVERYTHING ABOVE 11'-0" (P-5a); DO NOT PAINT EQUIPMENT INFORMATION TAGS!!

NOTE:

- REFER TO SHEET E.0.500 FOR ALL CEILING POINTED LOW VOLTAGE DEVICES. REFER TO SHEET E.0.501 FOR INSTALLATION OF LOW VOLTAGE DEVICES.

NOTE:


- SEE SHEET E.0.101 FOR LIGHTING FIXTURE AND TRACK SCHEDULES.

NOTE:

- PRIOR TO START ANY INSTALLATION WORK, G.C. SHALL VERIFY FINAL LOCATION SYSTEM PLANS AS REQUIRED FOR THIS PROJECT (CCTV, SENSORMATIC, ETC.)

NOTE:

- SE DEBERA REVISAR LA ALTURA TOTAL EXISTENTE EN LOCAL

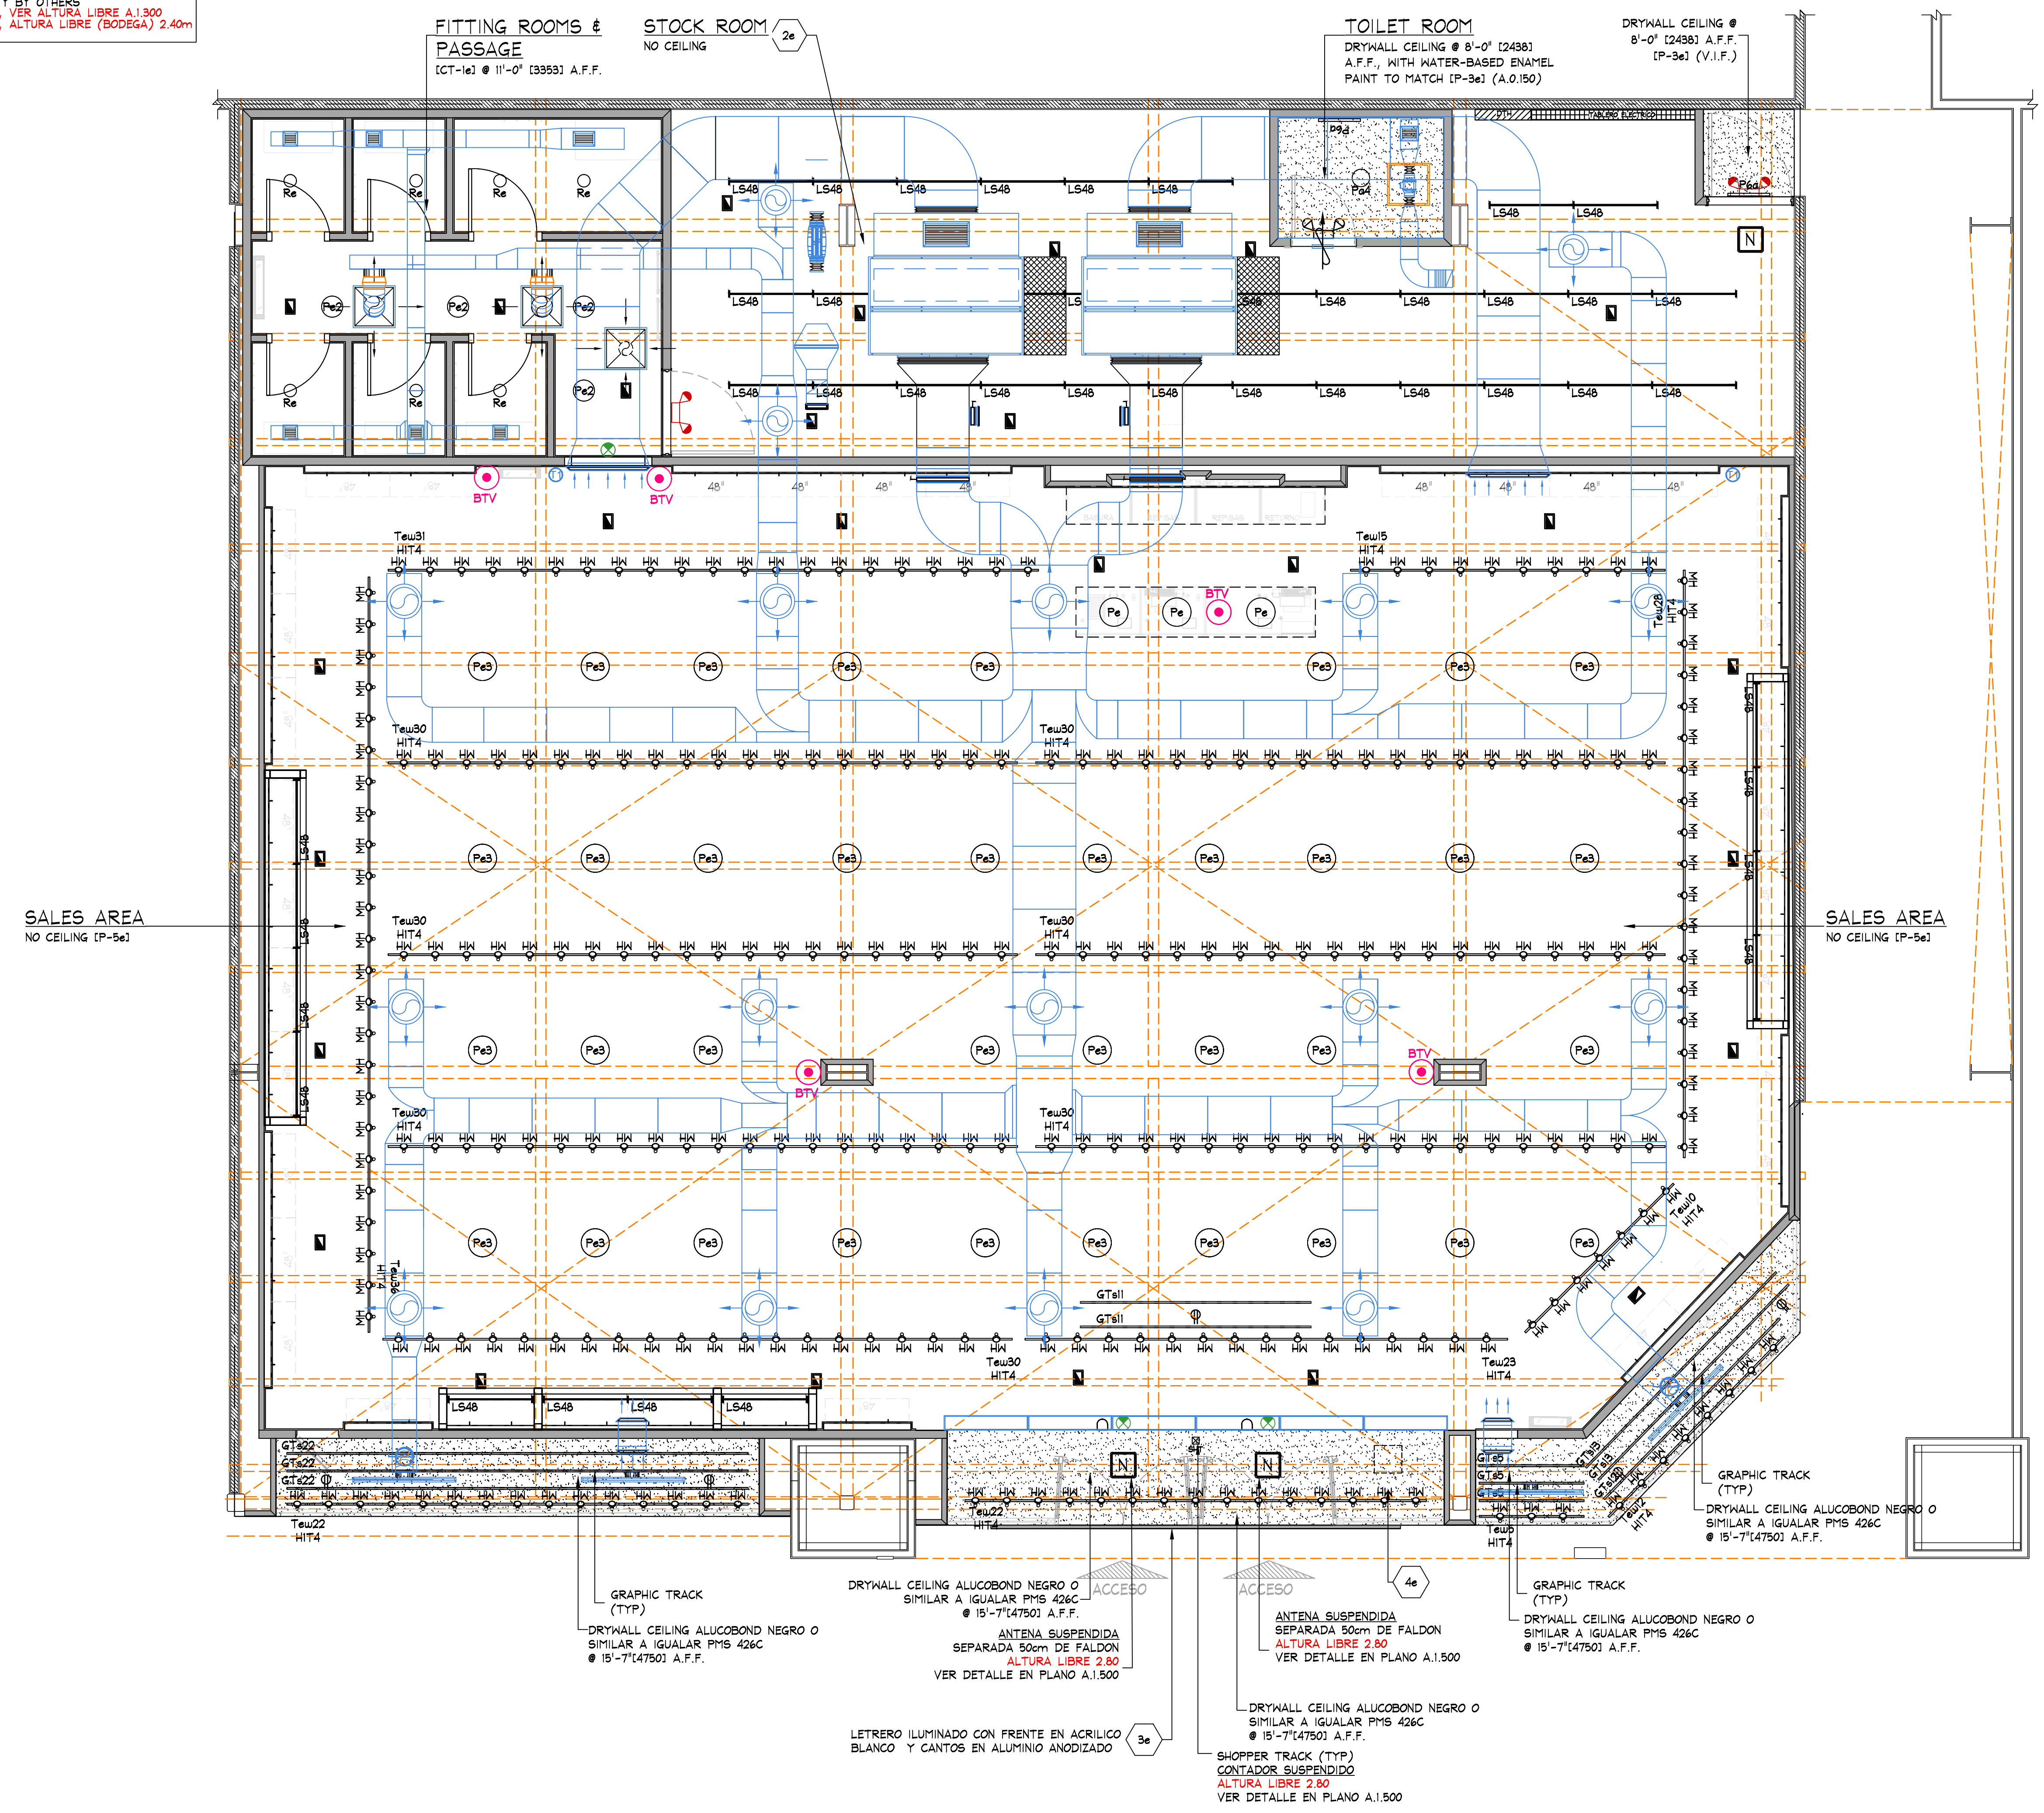

DEVICE COORDINATION REFLECTED CEILING PLAN
SCALE: 1/4" = 1'-0" (1:50)

THINK ARCHITECTURE S.A. DE C.V.
Descartes 93, 1er piso Col. Anzures
Miguel Hidalgo C.P.11590 Mexico

AMERICAN EAGLE

AMERICAN EAGLE OUTFITTERS, INC.
777 Main Street
Pittsburgh, PA 15203
(412) 432-3300

DEVICE COORDINATION
CEILING PLAN

AMERICAN EAGLE OUTFITTERS
Centro Los Americas Ecatepec
Ecatepec, Estado de Mexico


Store No.

9277

Drawn by:

Drawn No.

A.0.205

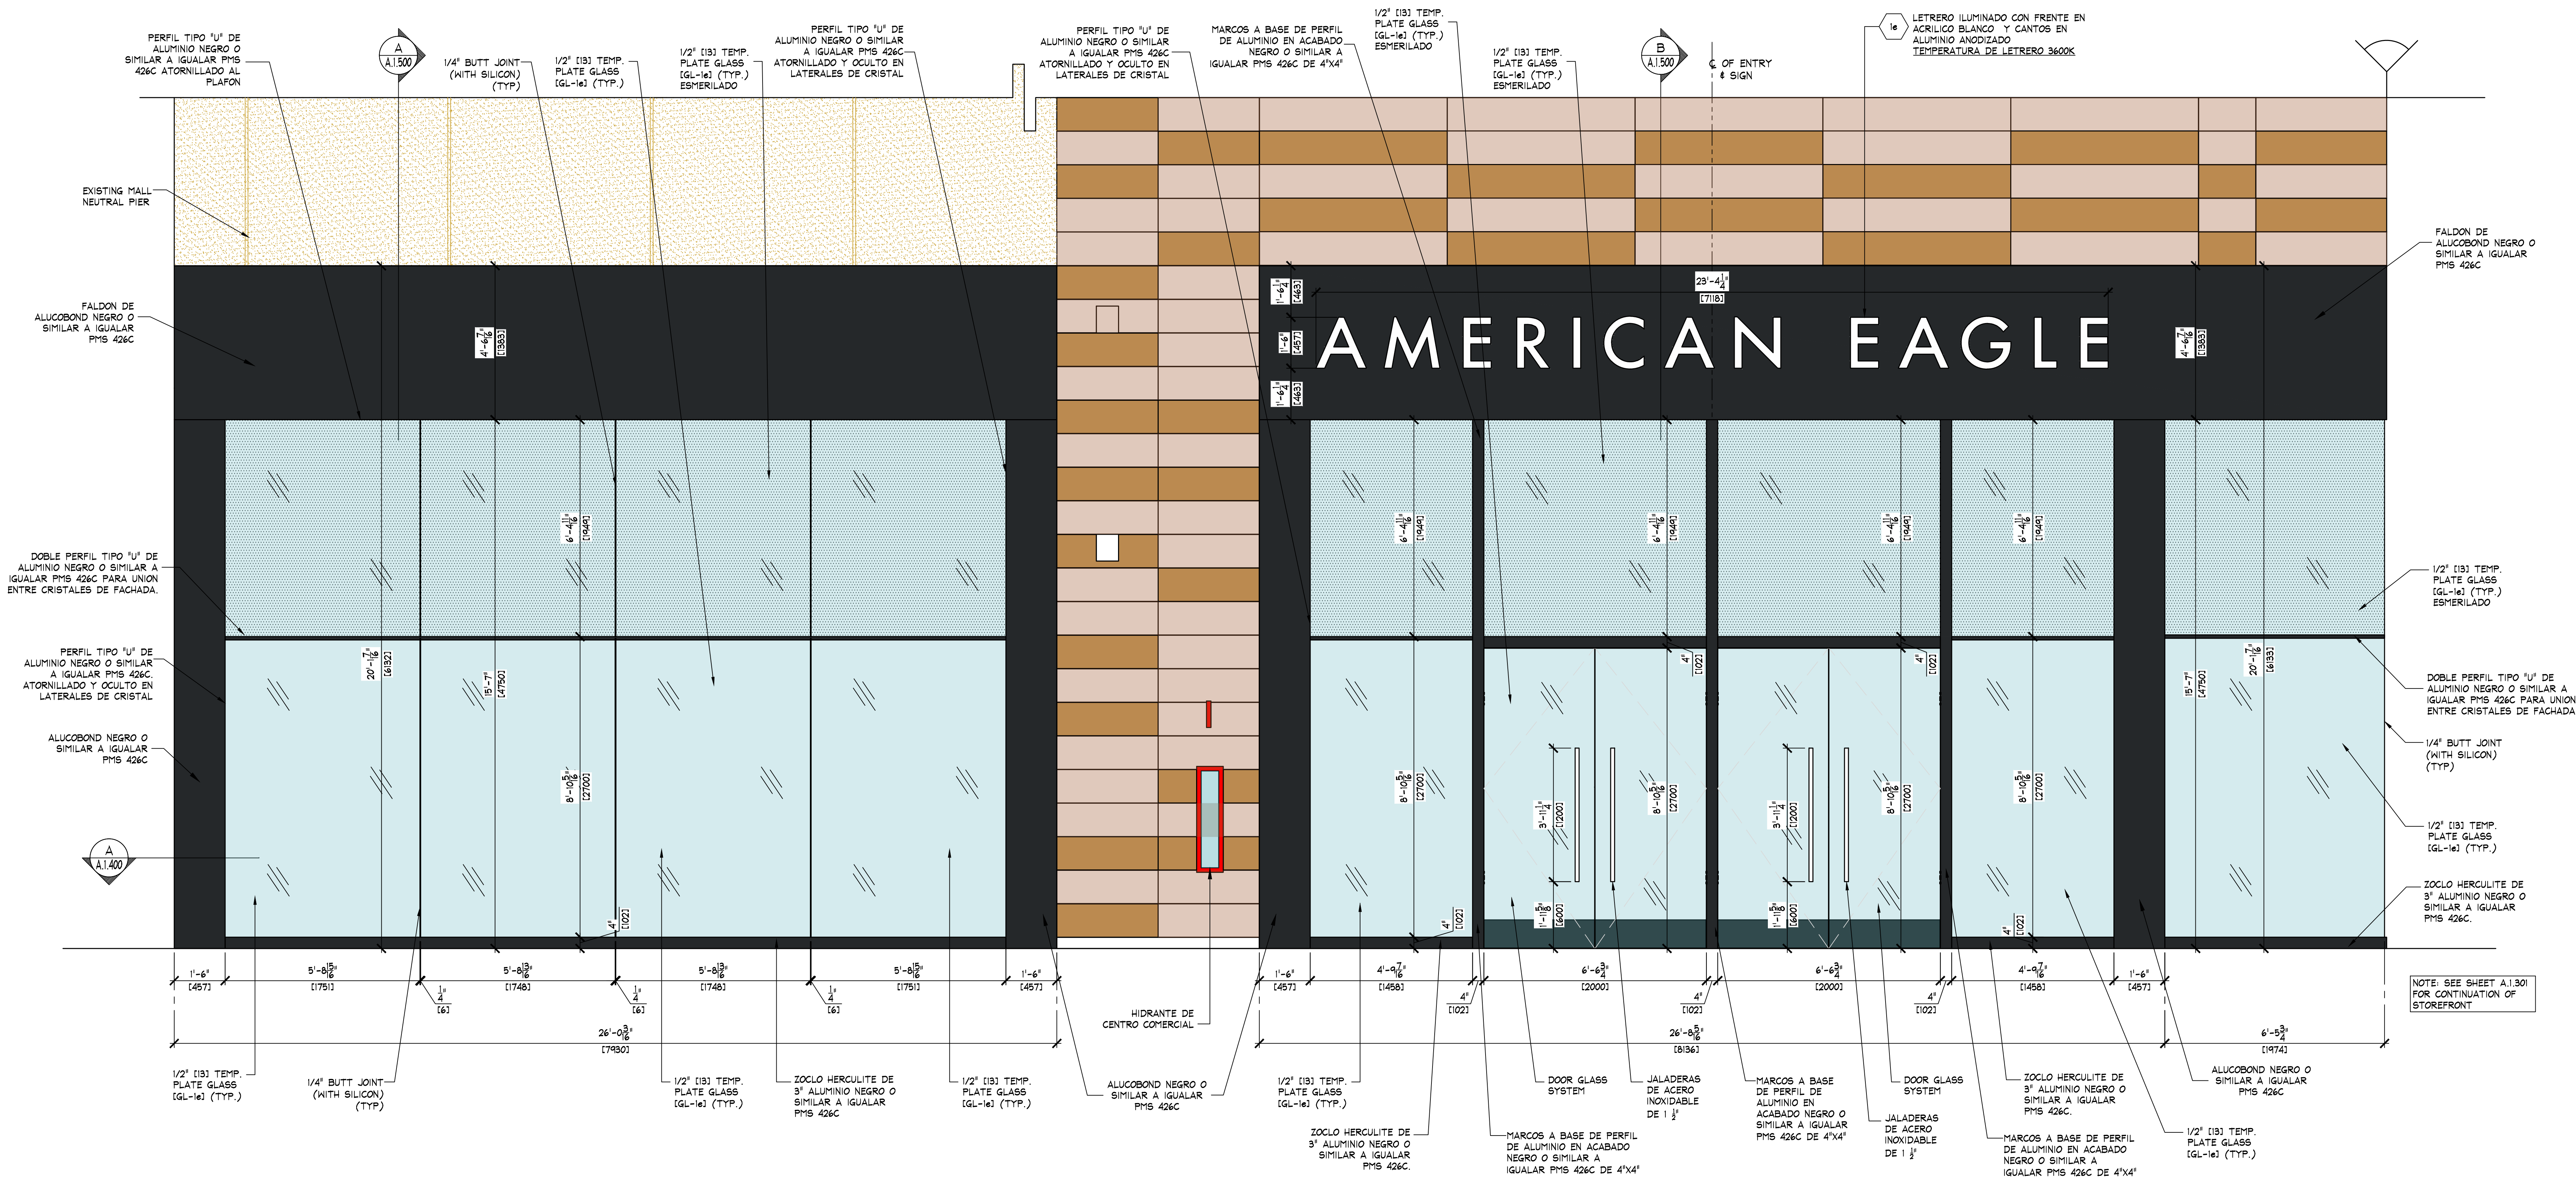

A STOREFRONT ELEVATION
A.1.300 SCALE: 1/2" = 1'-0" [1:25]

NOTE:
PAINTING CONTRACTOR SHALL
CAULK ALL INSIDE WOOD CORNERS
AND JOINTS BETWEEN TRIM AND
WALL PRIOR TO PAINTING.

KEY NOTES:


1e SIGN - FURNISHED BY SIGN CONSULTANT,
INSTALLED BY G.C. - SEE SHEET 'A.1.800'
FOR MORE INFORMATION.


IMPORTANTE:

CANCELERIA Y SUJECION DE FACHADA MOSTRADA ES CON
FINES ILUSTRATIVOS BASADO EN PROYECTOS REALIZADOS
ANteriormente; REVISAR Y AJUSTAR UNA VEZ RECIBIDO
EL PROYECTO DE CANCELERIA POR PARTE DE PROVEEDOR


IMPORTANTE:

FACHADA PENDIENTE DE REVISION CON CENTRO COMERCIAL
VERIFICAR EN SITIO MEDIDAS PREVIO A TRABAJOS DE
FACHADA, ASI COMO APROBACION POR PARTE DE AE Y C.C.

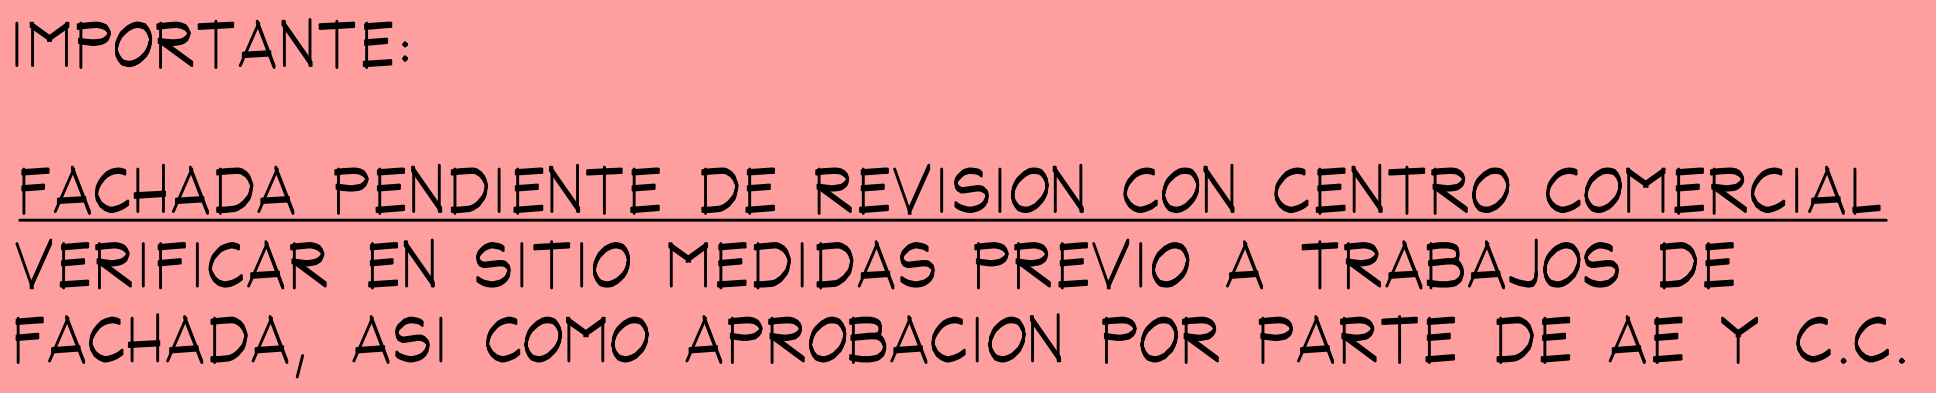


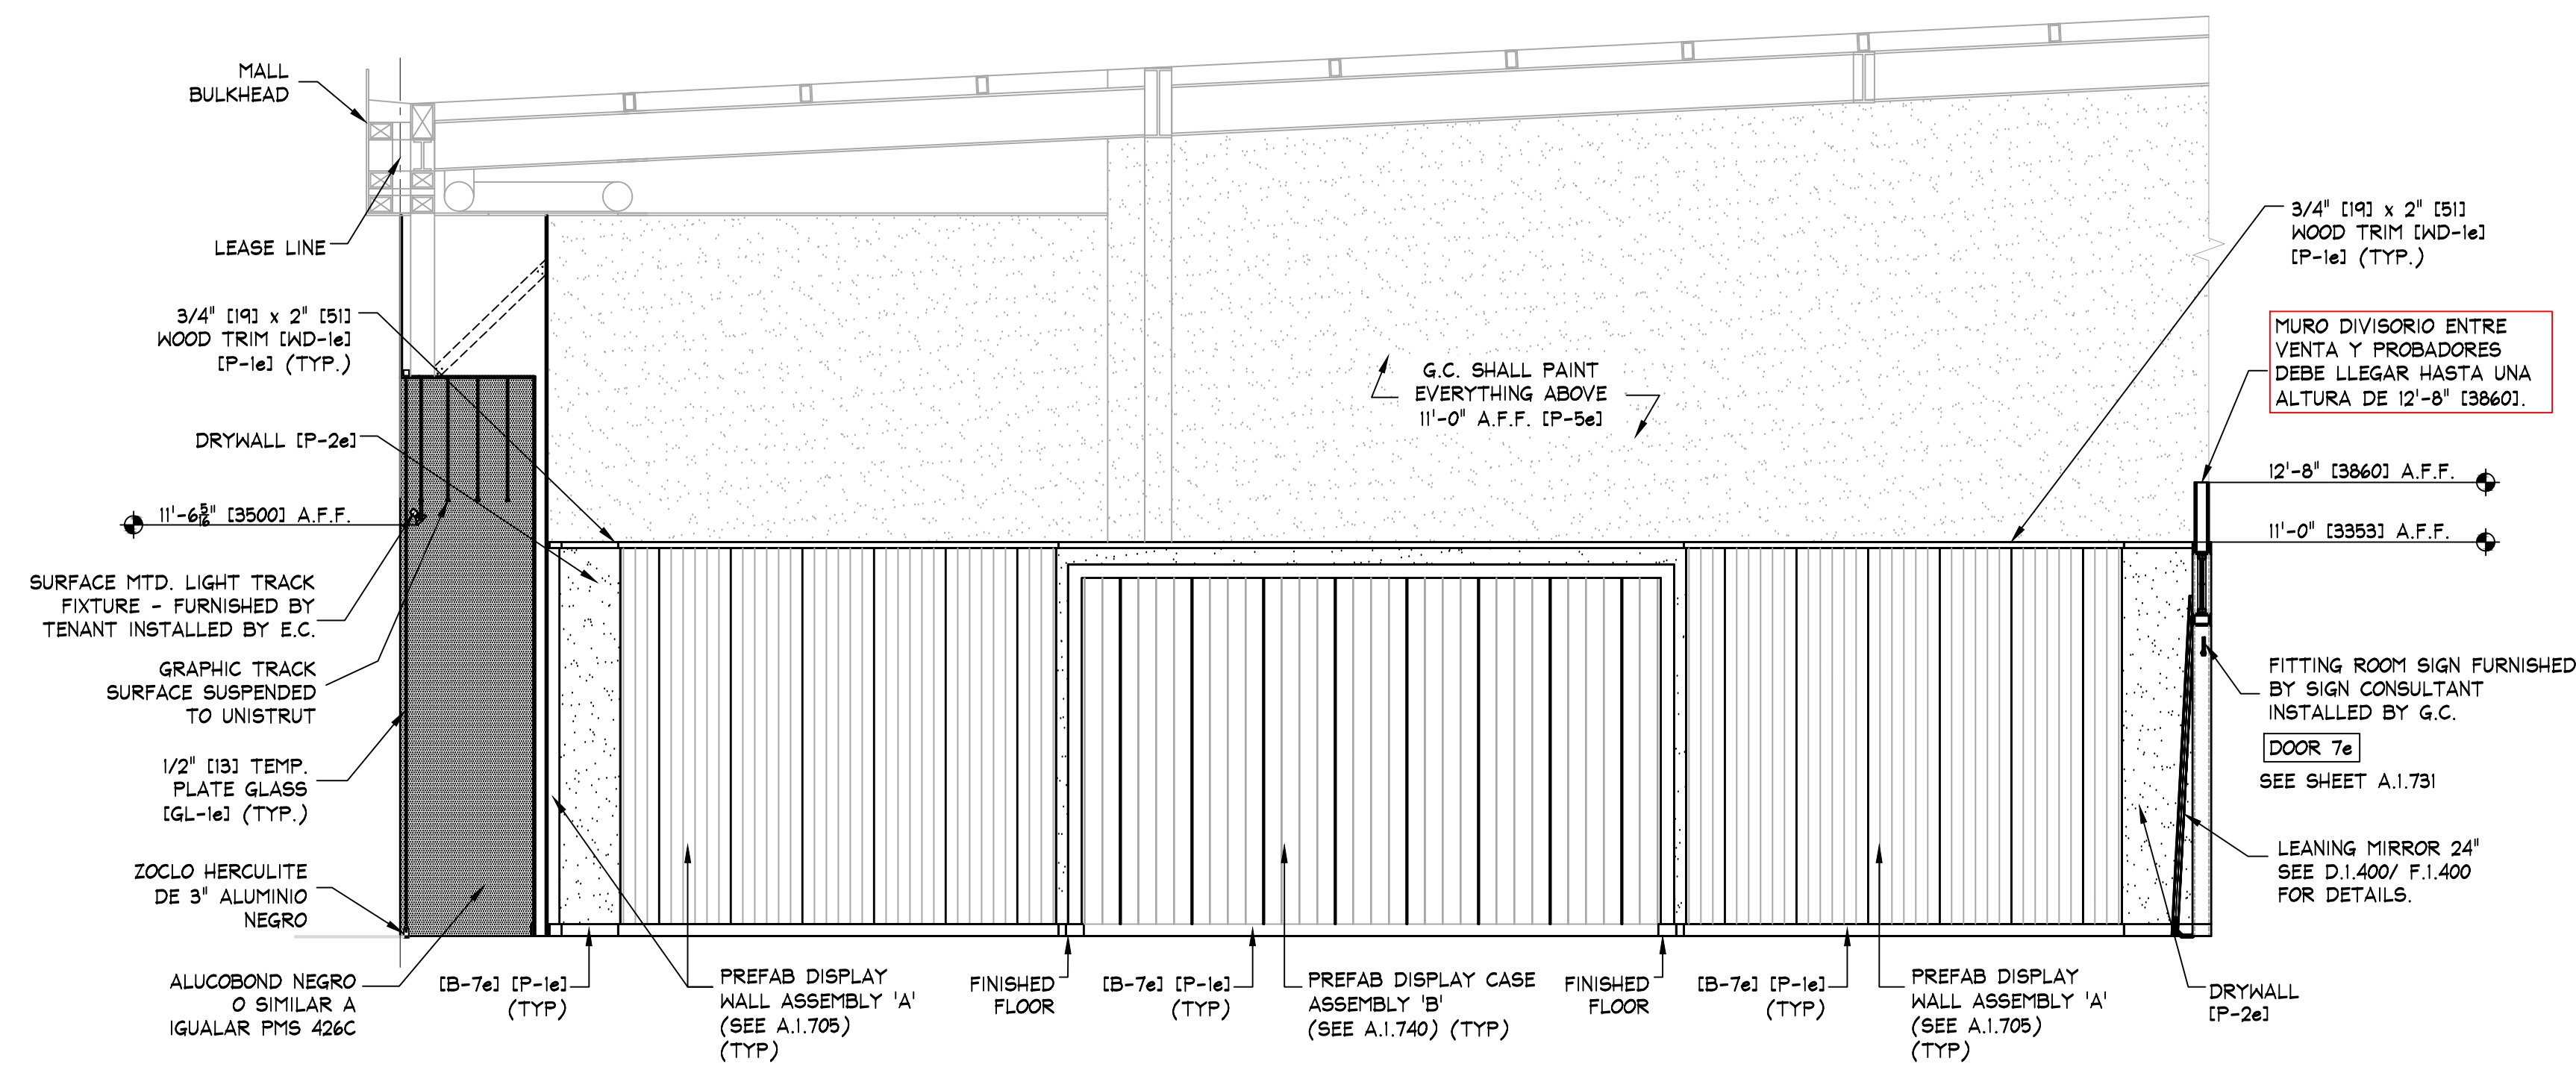

B
A.1.600
ELEVATION
SCALE: 1/4" = 1'-0" (1:50)






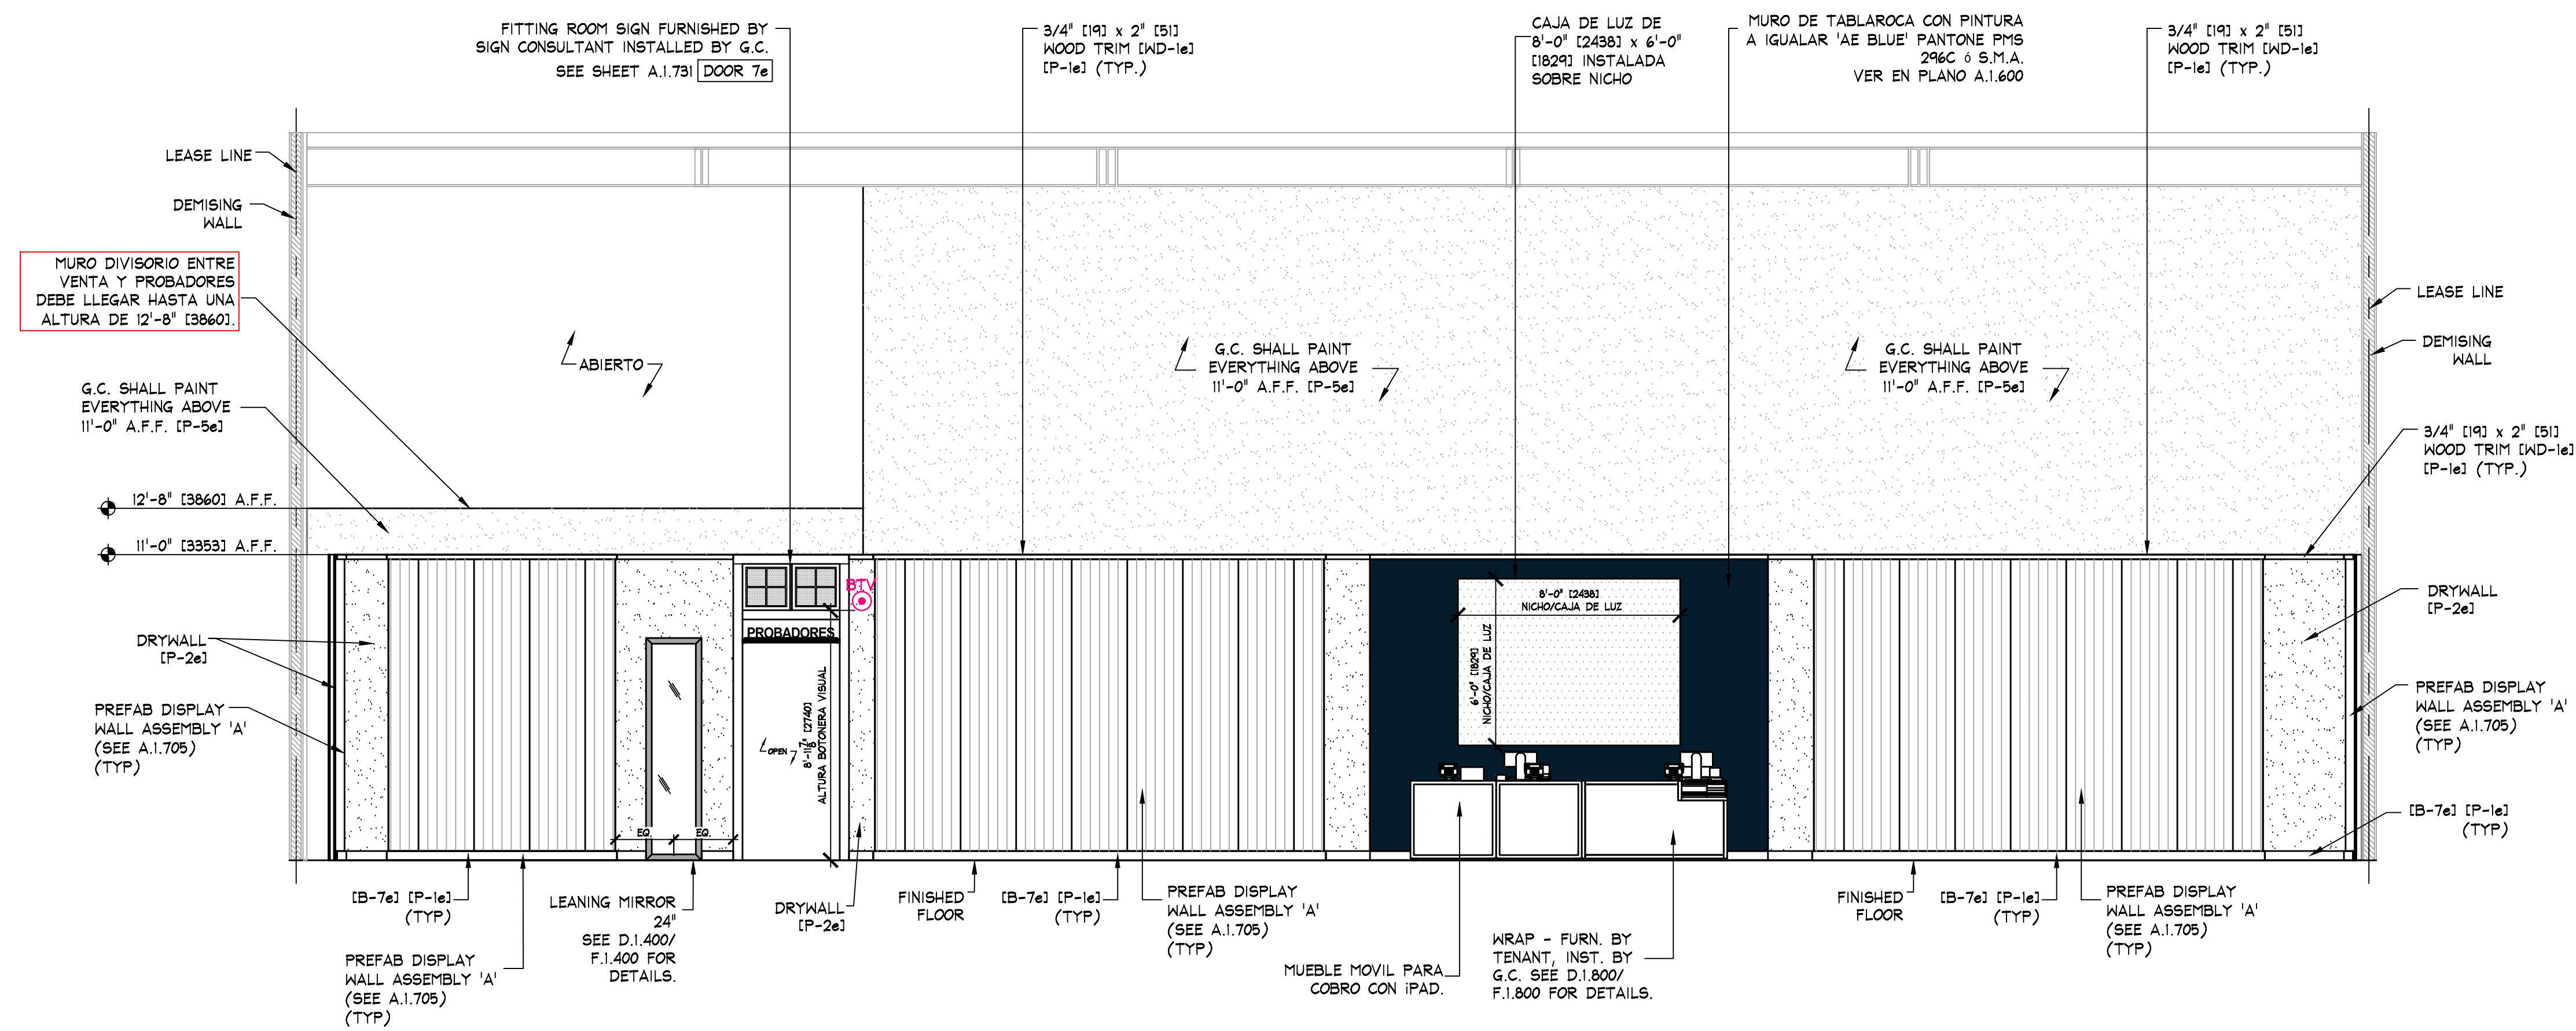


C
A.1.600
ELEVATION
SCALE: 1/4" = 1'-0" (1:50)

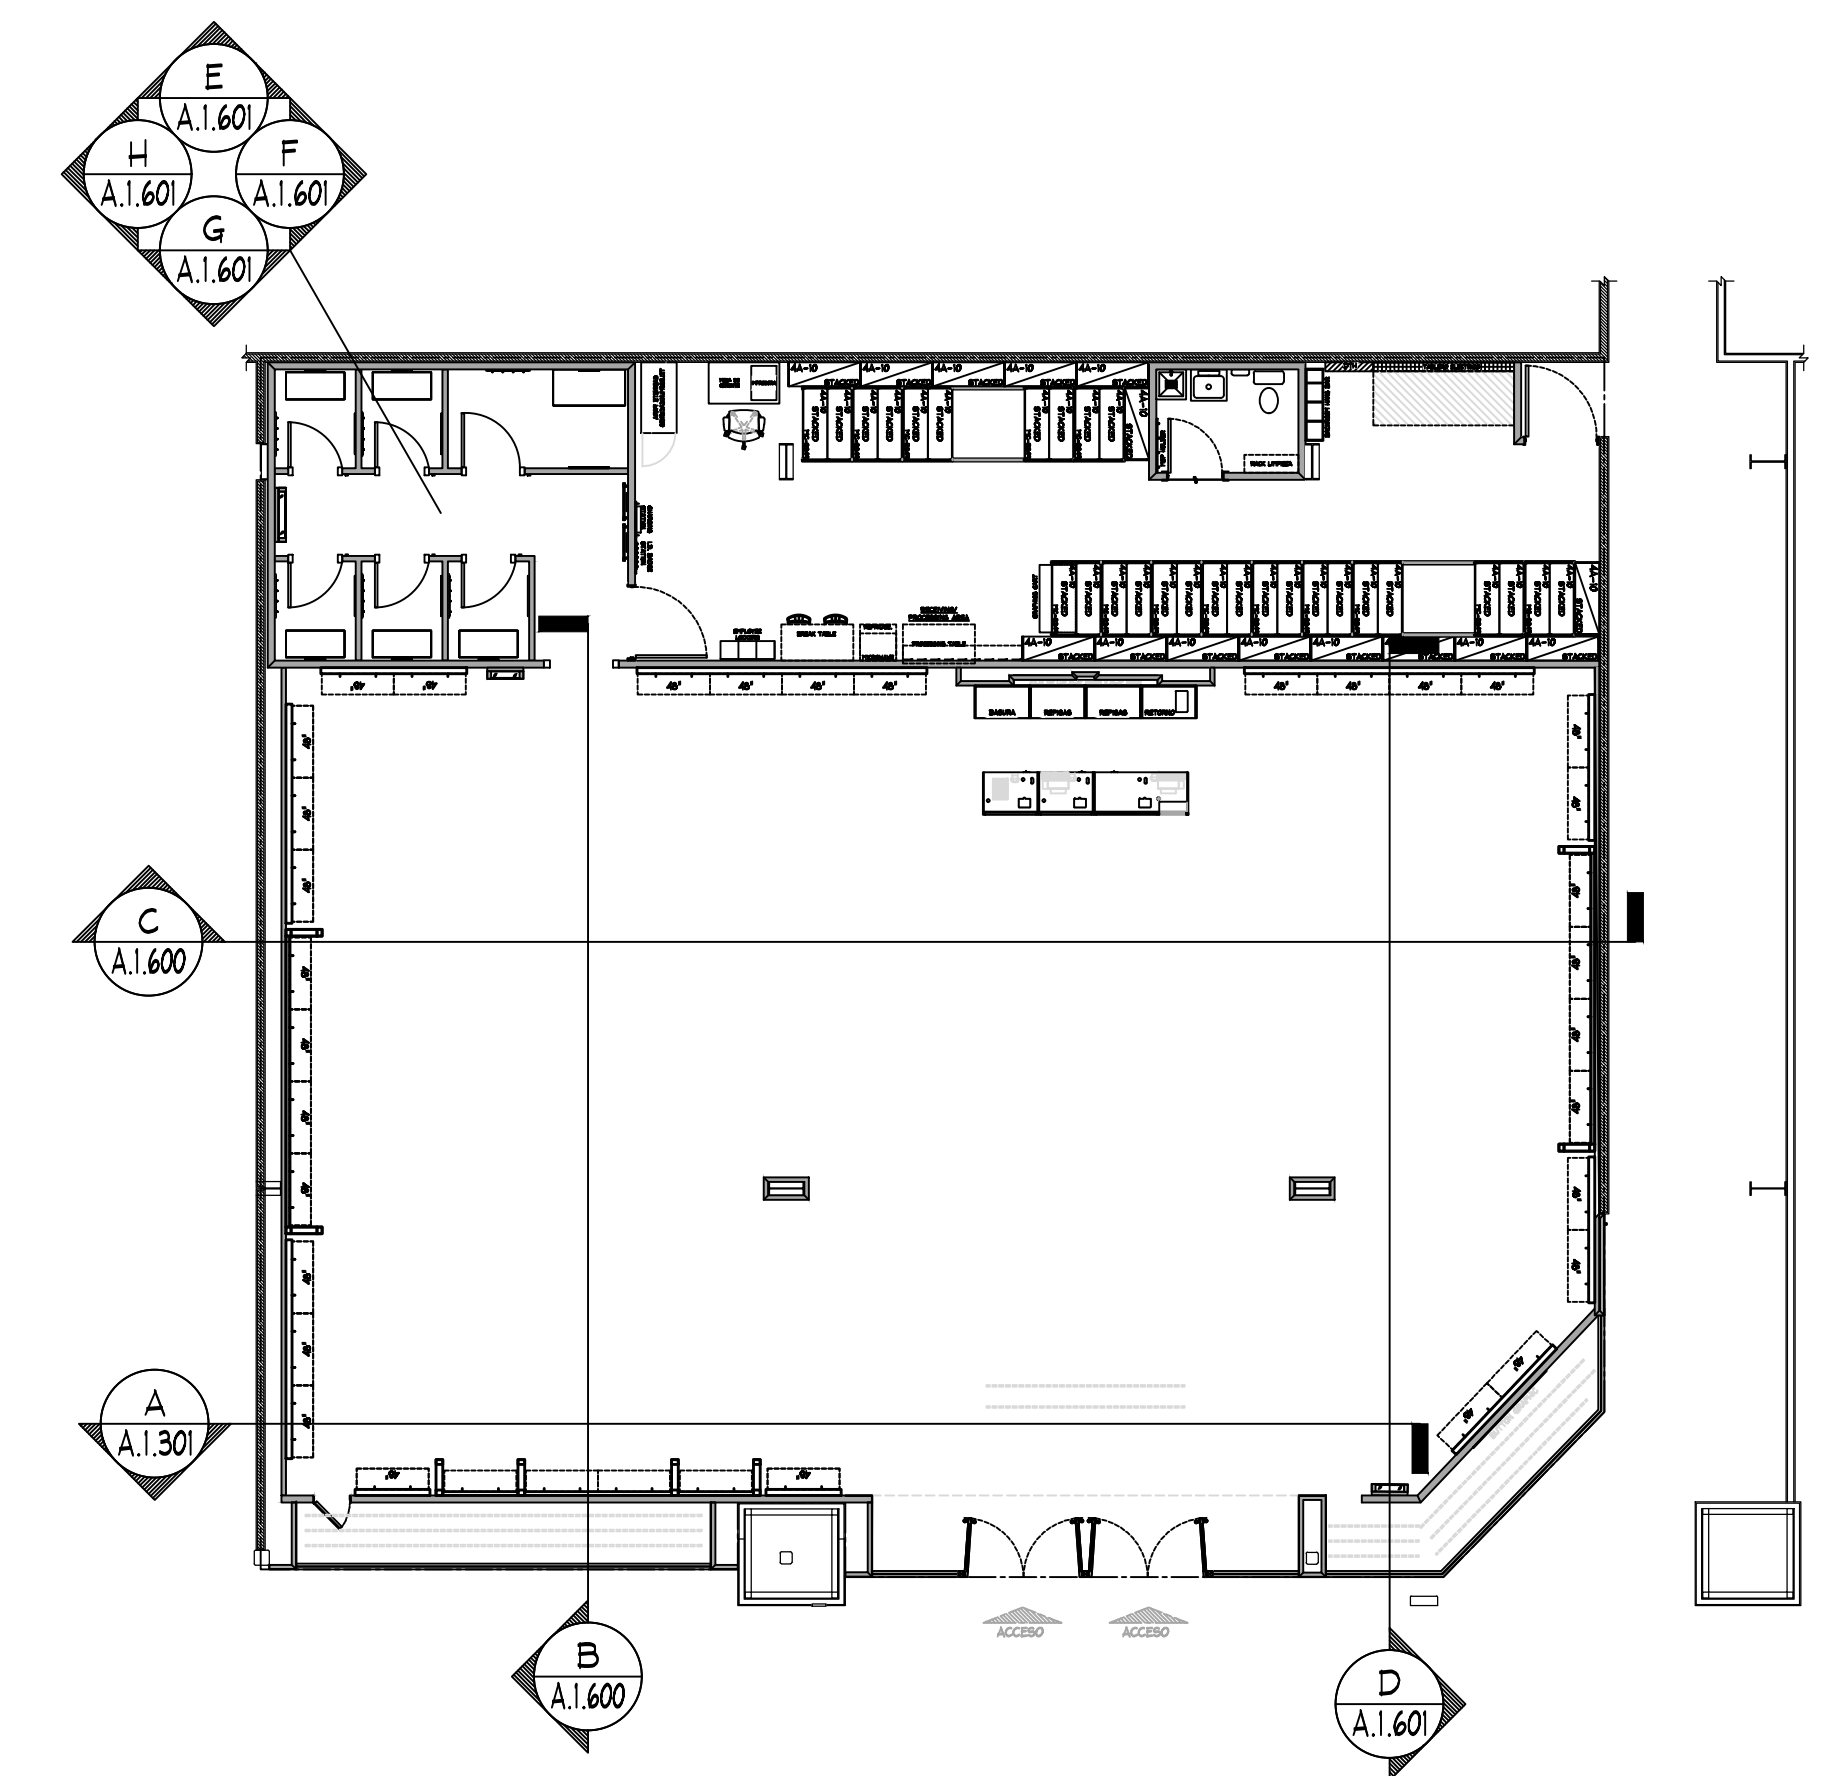

ELEVATION KEY
NO SCALE

NOTE:
DETAILS, NOTES, AND/OR SPECIFICATIONS ON THIS SHEET NOT LISTED ALPHABETICALLY OR NUMERICALLY HAVE BEEN PURPOSELY OMITTED AND DO NOT PERTAIN TO THIS PROJECT.

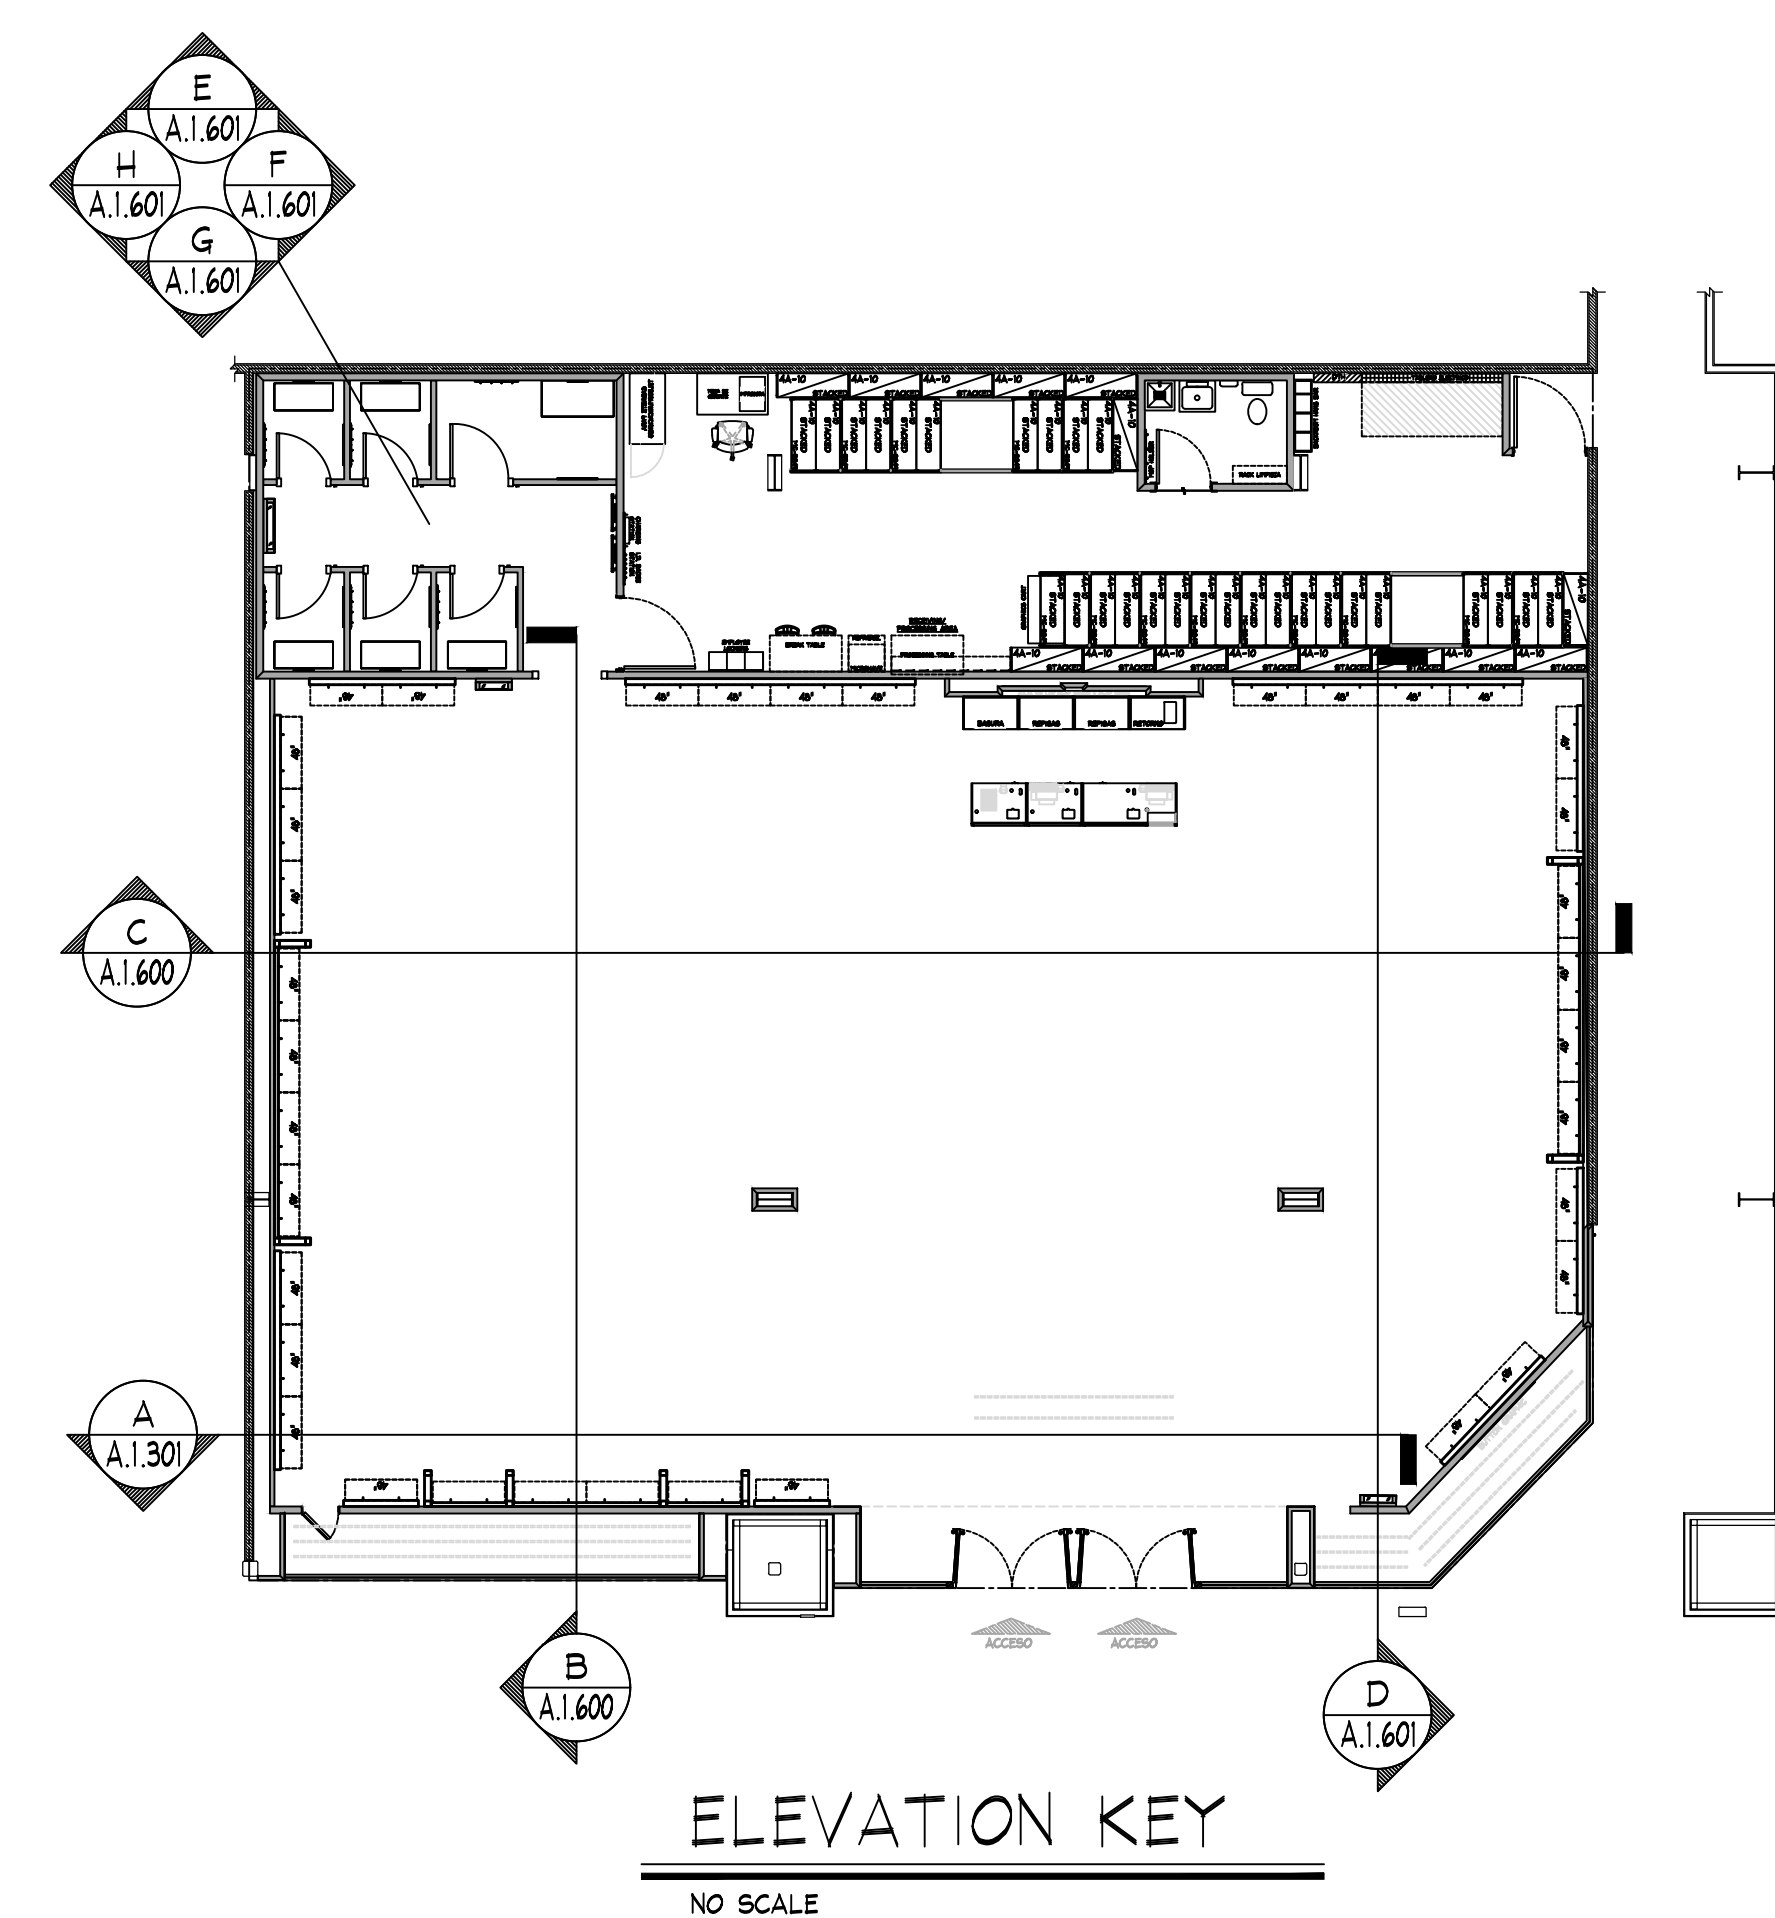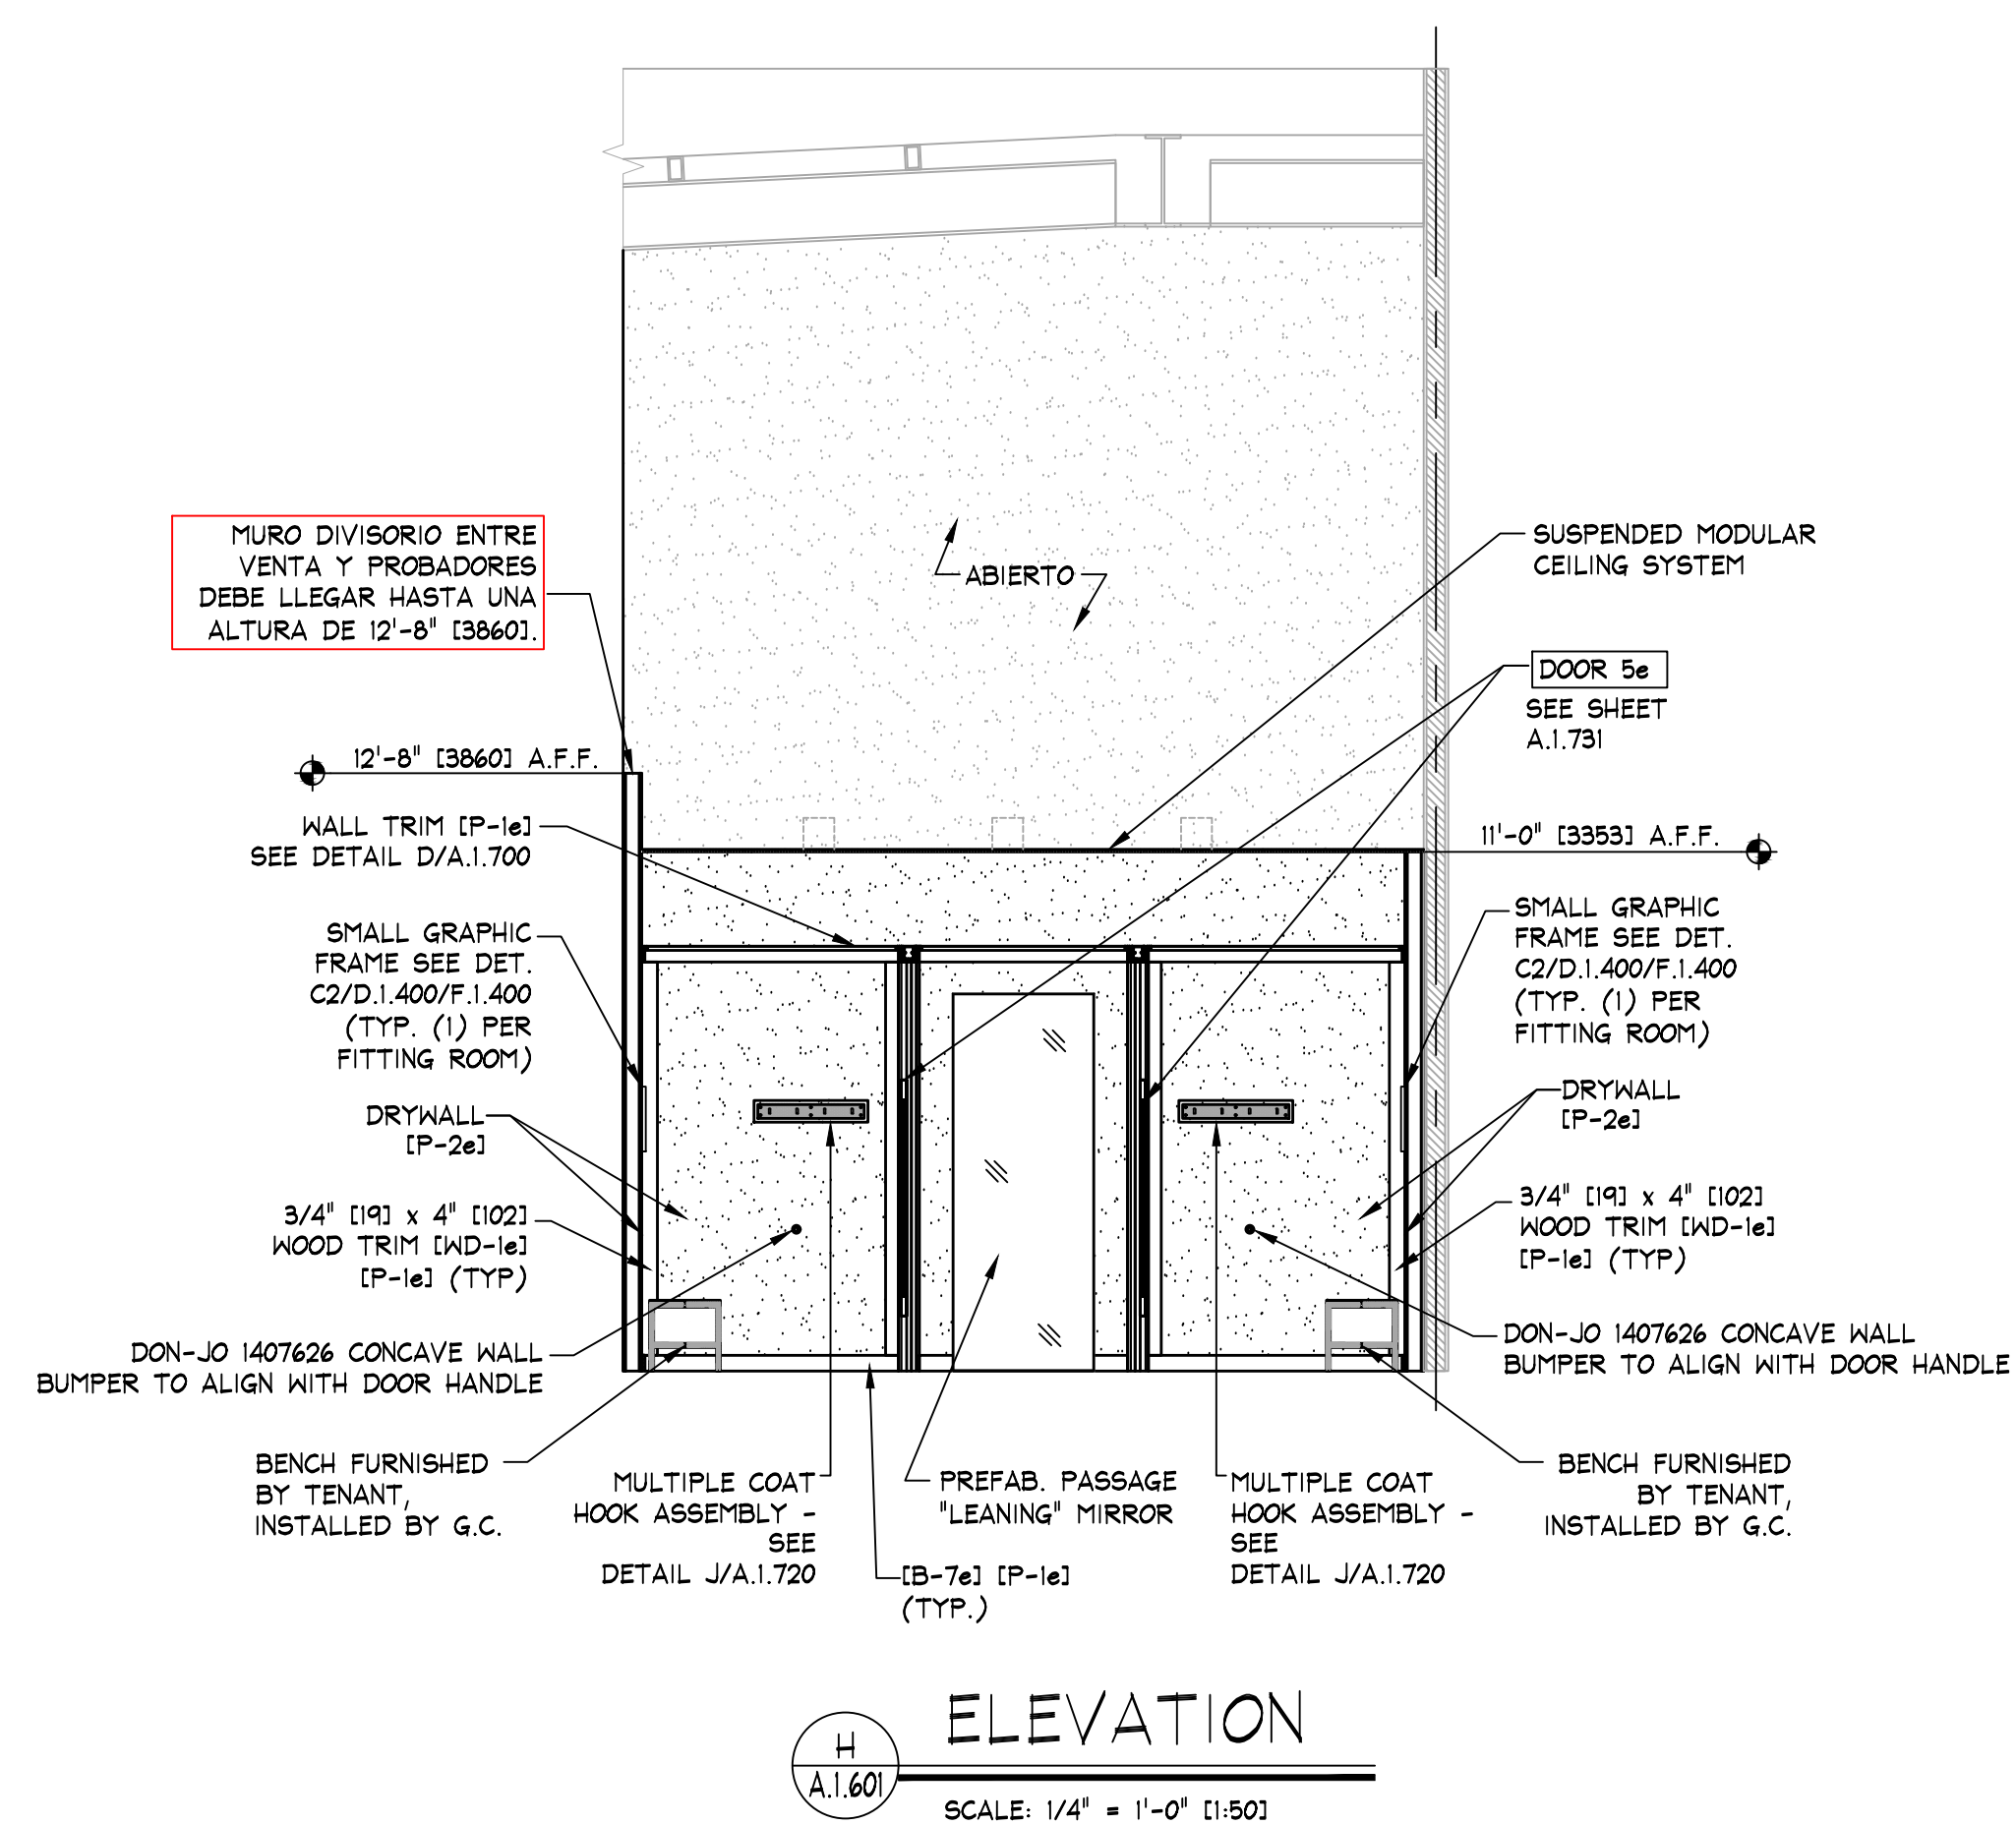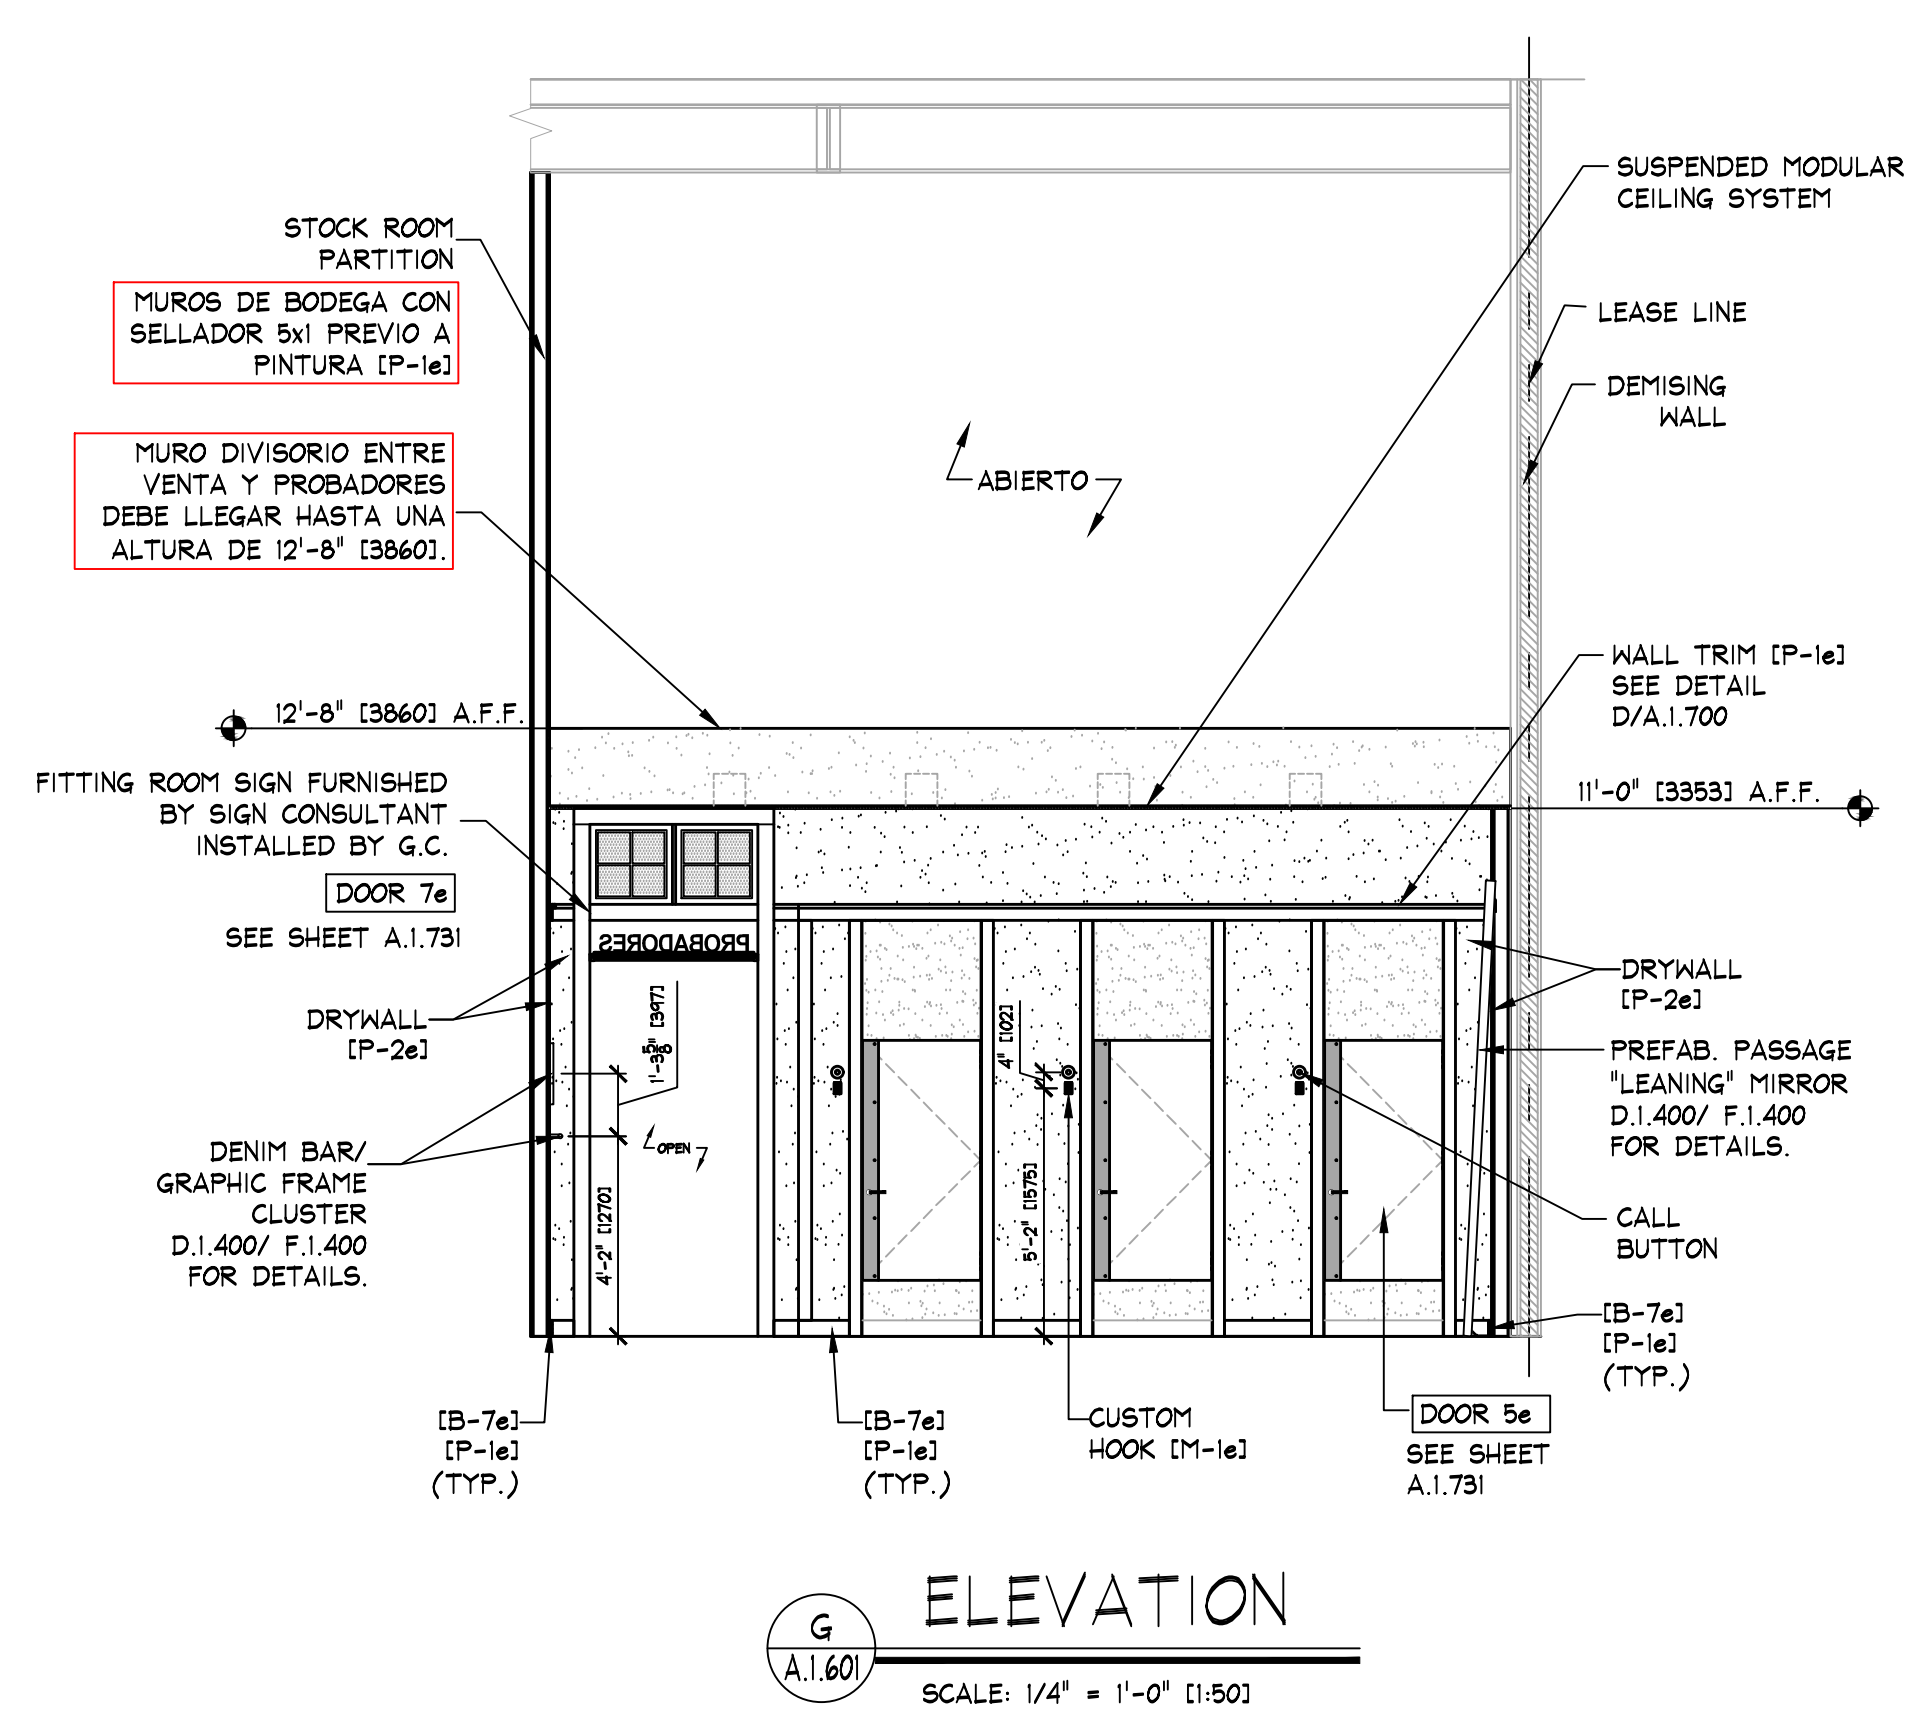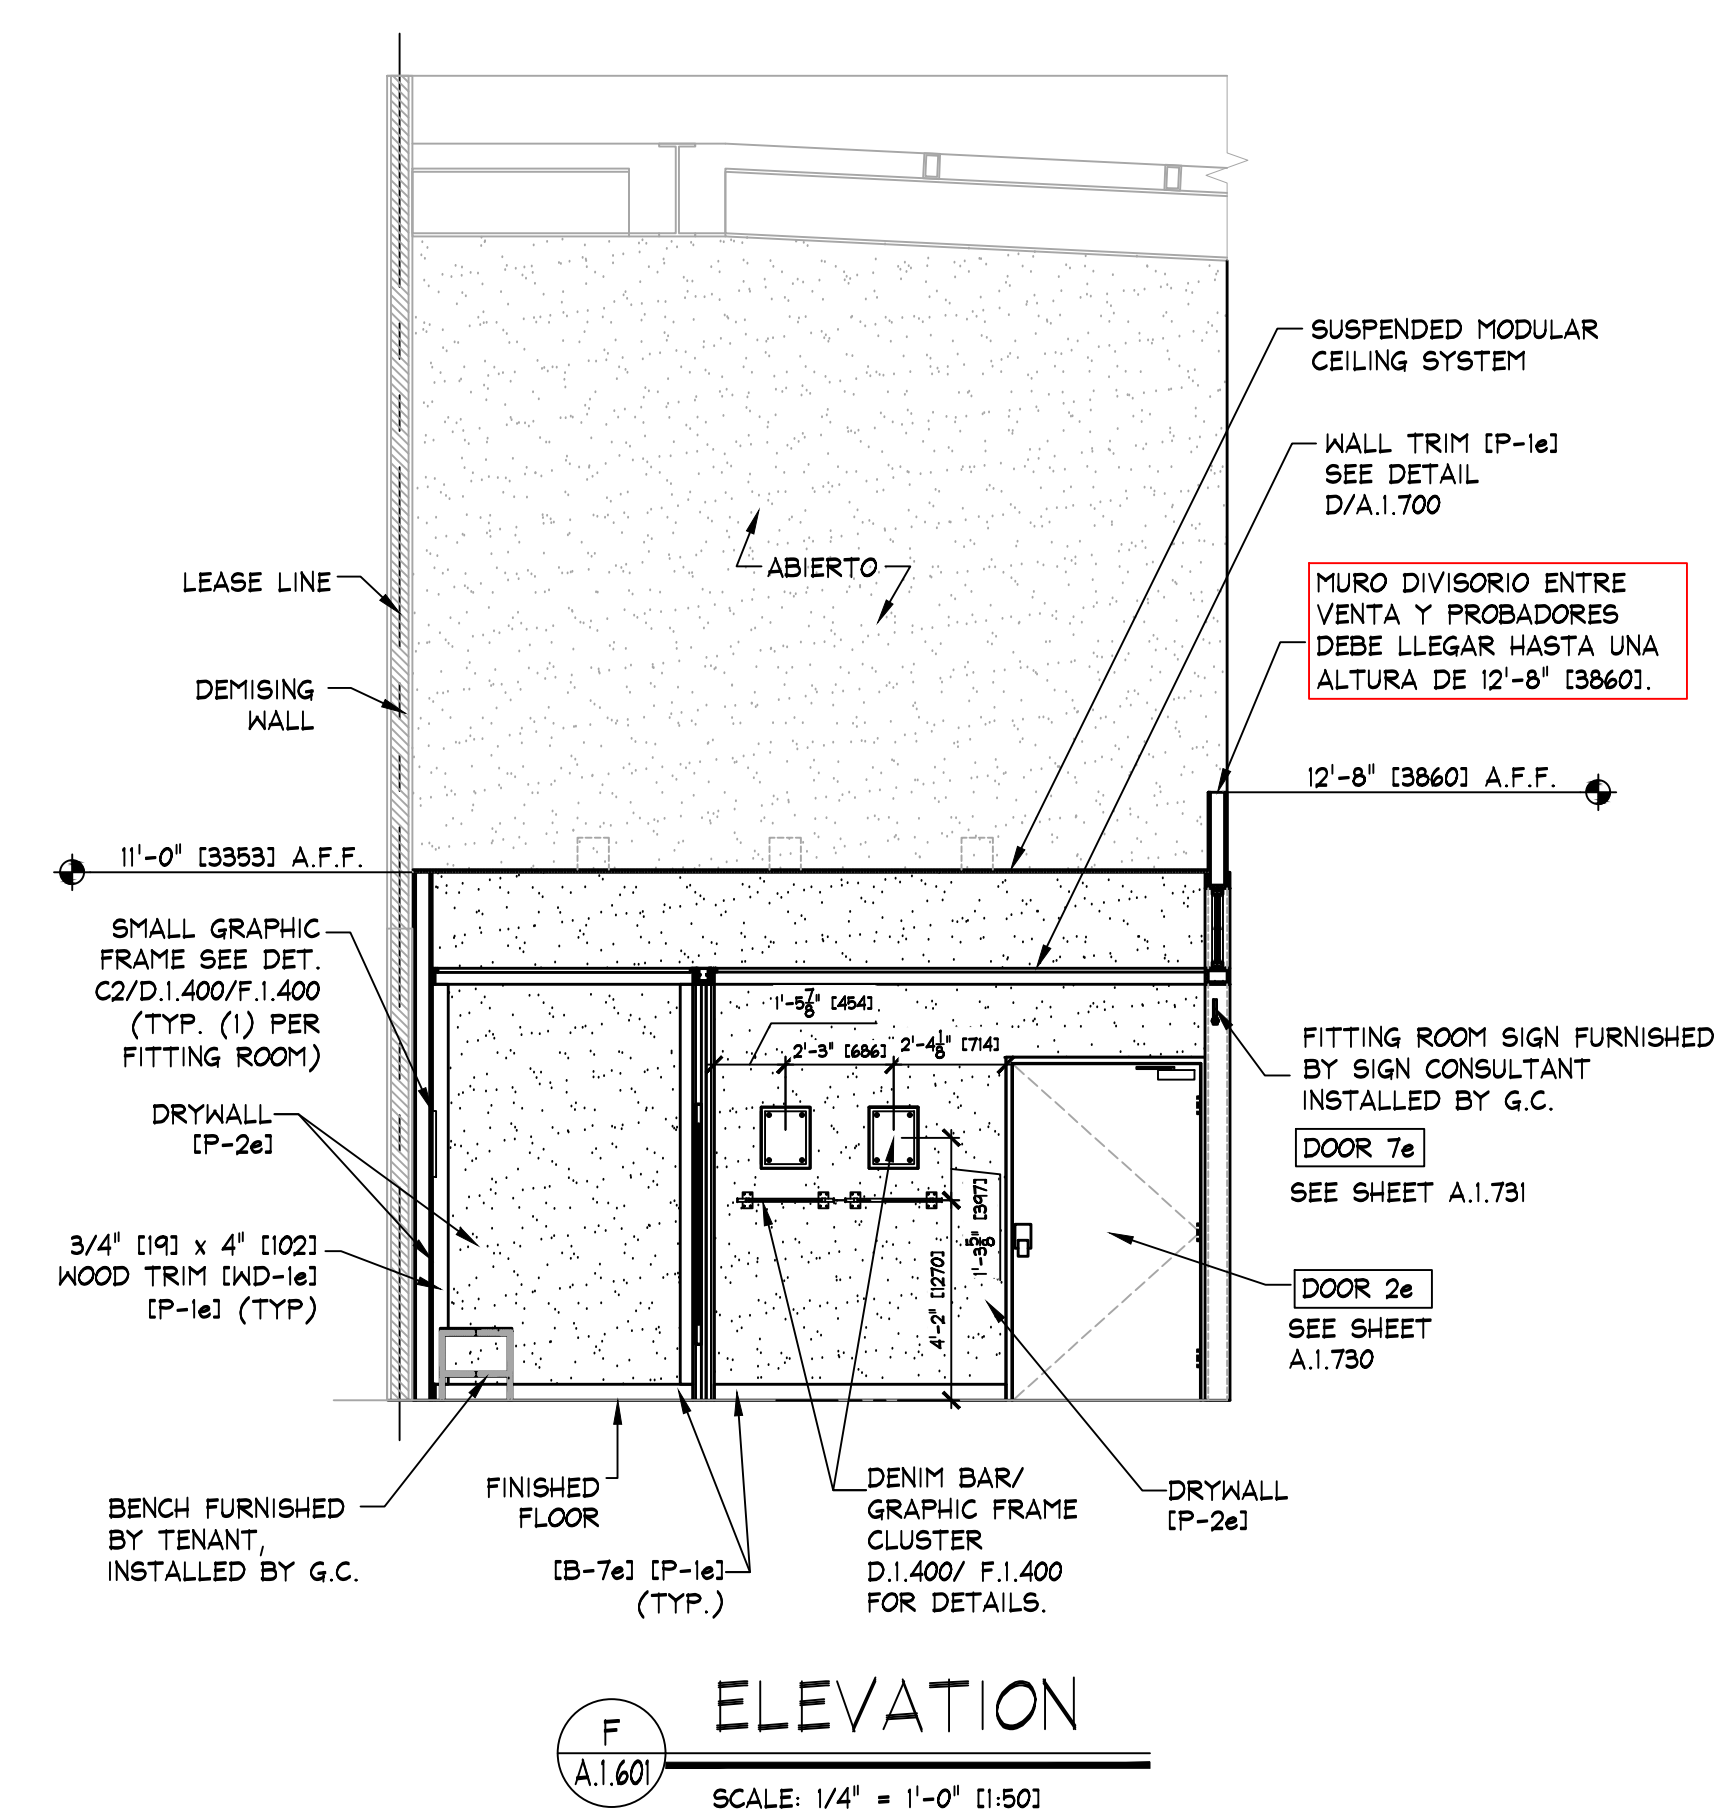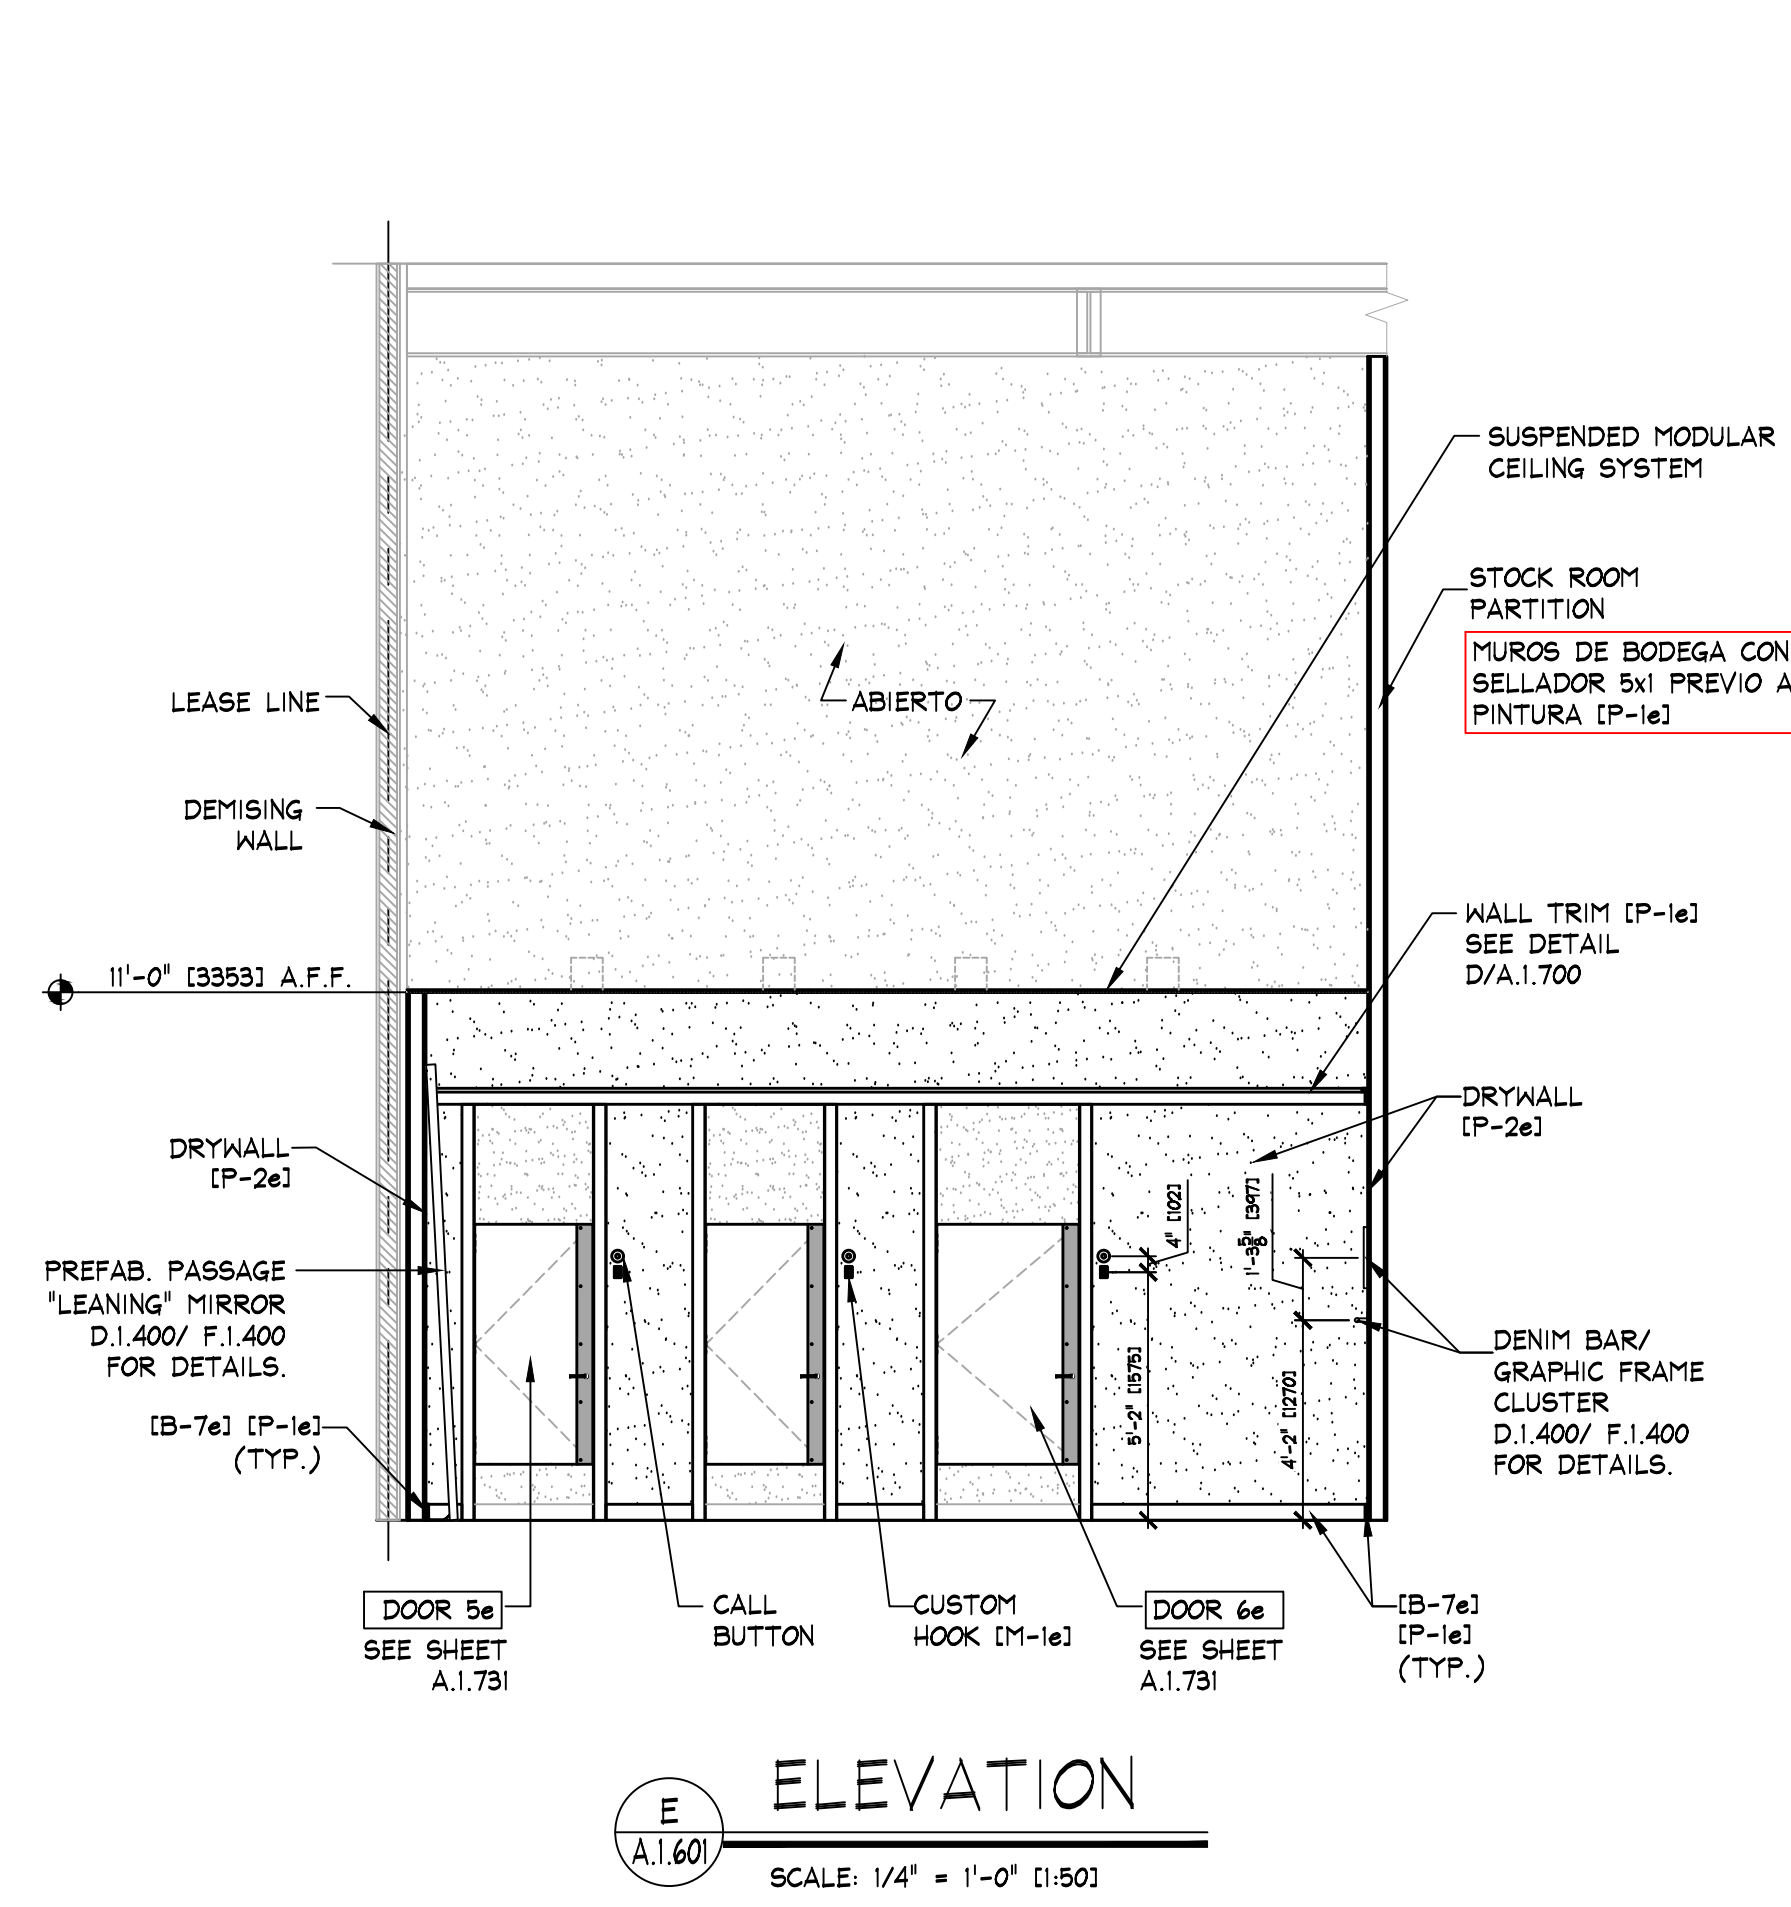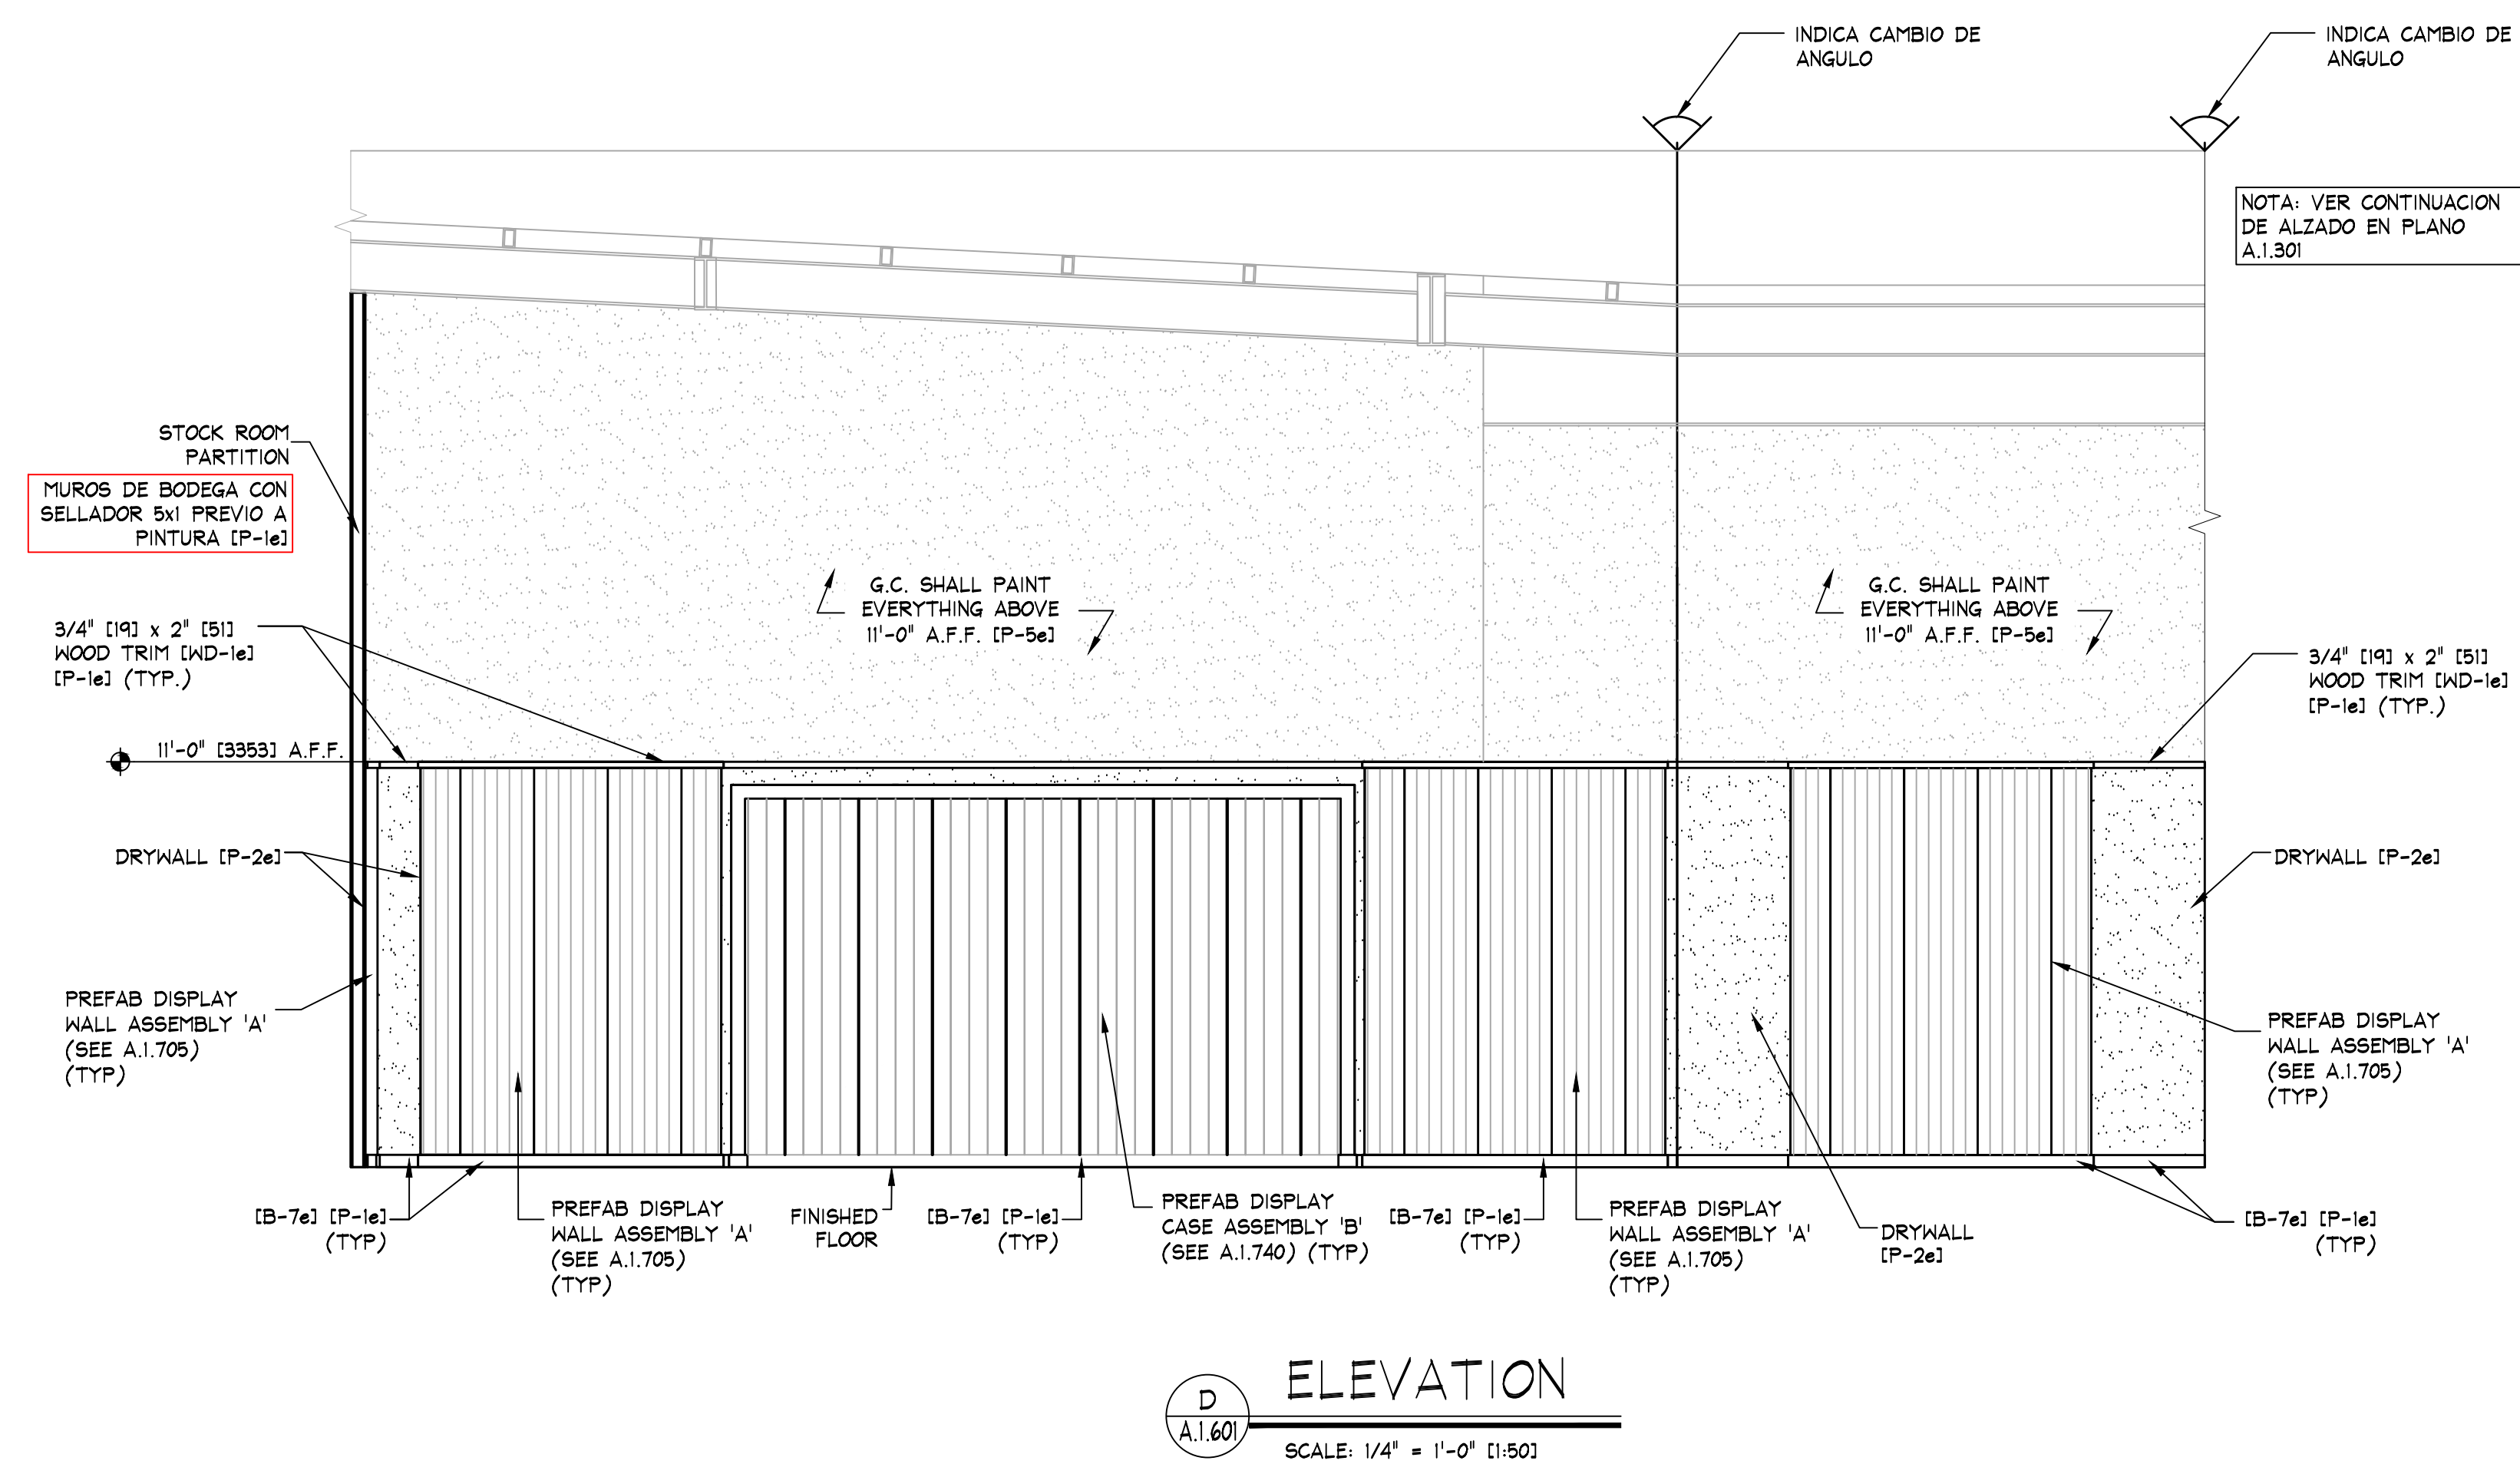

NOTE:
DETAILS, NOTES, AND/OR SPECIFICATIONS ON
THIS SHEET NOT LISTED ALPHABETICALLY OR
NUMERICALLY HAVE BEEN PURPOSELY OMITTED
AND DO NOT PERTAIN TO THIS PROJECT.

Store No.

9277

Drawn by: THINK

Drawing No.

A.1.601